

REPLAT NUMBER 1 OF
WASHTENAW COUNTY CONDOMINIUM
SUBDIVISION PLAN NO. 223

EXHIBIT B TO THE FIRST AMENDMENT
TO THE MASTER DEED OF

MEADOW GROVE

A CONDOMINIUM IN PITTSFIELD
TOWNSHIP, WASHTENAW COUNTY,
MICHIGAN

DEVELOPER:
MEADOW GROVE DEVELOPMENT COMPANY L.L.C.
3300 EAST PARIS, S.E.
KENTWOOD, MICHIGAN 49512

ARCHITECT:
J. BRADLEY MOORE AND ASSOCIATES
ARCHITECTS, INC.
317 S. DIVISION, SUITE 1510
ANN ARBOR, MICHIGAN 48104

ENGINEER/SURVEYOR:
ATWELL-HICKS, INC.
540 AVIS DRIVE
ANN ARBOR, MICHIGAN 48108

LEGAL DESCRIPTION:

DESCRIPTION OF CONDOMINIUM BOUNDARY

Commencing at the North 1/4 corner of Section 7, T3S, R6E, Pittsfield Township, Washtenaw County, Michigan; thence N89°21'17"E 783.00 feet along the North line of said Section 7 and the centerline of Waters Road and its Easterly prolongation; thence S42°35'40"W 1624.77 feet along the centerline of Ann Arbor - Saline Road; thence S42°55'40"W 19.30 feet along said centerline of Ann Arbor - Saline Road; thence S47°04'20"E 60.00 feet; thence S42°55'40"W 375.36 feet along the South right-of-way line of said Ann Arbor - Saline Road; thence S00°38'20"W 338.14 feet; thence S89°21'40"W 120.32 feet; thence S00°54'00"E 847.09 feet for a PLACE OF BEGINNING; thence S82°57'09"E 143.13 feet; thence N10°06'41"E 35.41 feet; thence S79°53'19"E 88.95 feet; thence N10°06'41"E 13.71 feet; thence N89°02'00"E 428.48 feet along the East-West 1/4 line of said Section 7 to the Center of said Section 7; thence N63°07'06"E 124.58 feet; thence N80°00'00"E 102.15 feet; thence N63°07'06"E 66.94 feet; thence N74°15'35"E 106.01 feet; thence the following four courses along the Westerly right-of-way line of Burnham Road (86 feet wide): 242.46 feet along the arc of a 583.00 foot radius non-tangential circular curve to the right, chord bearing N18°22'06"E 240.71 feet, N30°16'56"E 86.71 feet, 174.84 feet along the arc of a 517.00 foot radius circular curve to the left, chord bearing N20°35'39"E 174.01 feet, and N10°54'21"E 49.86 feet; thence along the Southerly right-of-way line of Oak Valley Drive (86 feet wide) and 66.02 feet along the arc of a 693.00 foot radius non-tangential circular curve to the left, chord bearing S79°06'14"E 66.00 feet; thence the following five courses along the Easterly right-of-way line of said Burnham Road: S10°54'21"W 49.87 feet, 197.16 feet along the arc of a 583.00 foot radius non-tangential circular curve to the right, chord bearing S20°35'39"W 196.22 feet, S30°16'56"W 86.71 feet, 281.97 feet along the arc of a 517.00 foot radius circular curve to the left, chord bearing S14°39'28"W 278.49 feet and S00°58'00"E 33.70 feet; thence S89°02'00"W 114.75 feet along the East-West 1/4 line of said Section 7; thence S00°20'51"E 1000.06 feet; thence S89°02'00"W 321.05 feet; thence N00°28'25"W 344.43 feet along the North-South 1/4 line of said Section 7; thence S89°02'00"W 662.05 feet; thence N00°54'00"W 644.42 feet to the Place of Beginning, being a part of the W 1/2 of said Section 7, containing 18.81 acres of land, more or less, and being subject to easements and restrictions of record, if any.

SHEET INDEX:

SHEET	DESCRIPTION
*1	TITLE AND DESCRIPTIONS
*2	COMPOSITE PLAN
*3	SURVEY PLAN
*3A	SURVEY PLAN
*4	SITE PLAN
*4A	SITE PLAN
*5	UTILITY PLAN
*5A	UTILITY PLAN
*6	BUILDING TYPE 1
*7	"L" FLOOR PLAN
*8	"L" FLOOR PLAN
*9	PLAN "L" BUILDING SECTIONS
*10	"M" FLOOR PLAN
*11	"M" FLOOR PLAN
*12	PLAN "M" BUILDING SECTIONS
*13	BUILDING TYPE 2 BUILDING PLAN
*14	BUILDING TYPE 3 BUILDING PLAN
*15	BUILDING TYPE 4 BUILDING PLAN
*16	UNITS O,P,Q WALK-OUTS FLOOR PLANS
*17	UNITS O,P,Q BASEMENTS & VIEW-OUTS FLOOR PLANS
*18	UNIT O-WALK-OUTS SECTIONS
*19	UNIT P-WALK-OUTS SECTIONS
*20	UNIT Q-WALK-OUTS SECTIONS
*21	UNIT O-VIEW OUT SECTIONS
*22	UNIT P-VIEW OUT SECTIONS
*23	UNIT Q-VIEW OUT SECTIONS
*24	UNIT O-BASEMENT SECTIONS
*25	UNIT P-BASEMENT SECTIONS
*26	UNIT Q-BASEMENT SECTIONS

NOTE: THE ASTERISKS(*) SHOWN ABOVE INDICATE AMENDED OR NEW SHEETS. THESE SHEETS WITH THE SUBMISSION ARE TO REPLACE THOSE SHEETS PREVIOUSLY RECORDED.

PROPOSED DATE: FEB. 13, 1998

Todd Pascoe
TODD PASCOE
PROFESSIONAL ENGINEER NO. 36125
ATWELL-HICKS, INC.
540 AVIS DRIVE
ANN ARBOR, MICHIGAN 48108
(313) 994-4000



TITLE AND DESCRIPTIONS
MEADOW GROVE

ATWELL-HICKS, INC.
CIVIL ENGINEERING & SURVEYING, PLANNING
ENVIRONMENTAL SERVICES
313-994-4000 • FAX NO. 313-994-1599
ANN ARBOR, MICHIGAN

SECTION 7
TOWNSHIP 3 SOUTH, RANGE 6 EAST
PITTSFIELD TOWNSHIP
WASHTENAW COUNTY, MICHIGAN

TITLE AND DESCRIPTIONS
MEADOW GROVE

CAD FILE
1210001

REVISIONS

DATE 8-1-85


SCALE

DR CD CH MM



BOOK

JOB 41361

FILE NO
137-345-1

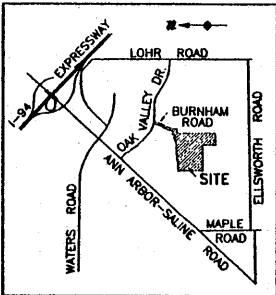

VICINITY MAP
(NO SCALE)

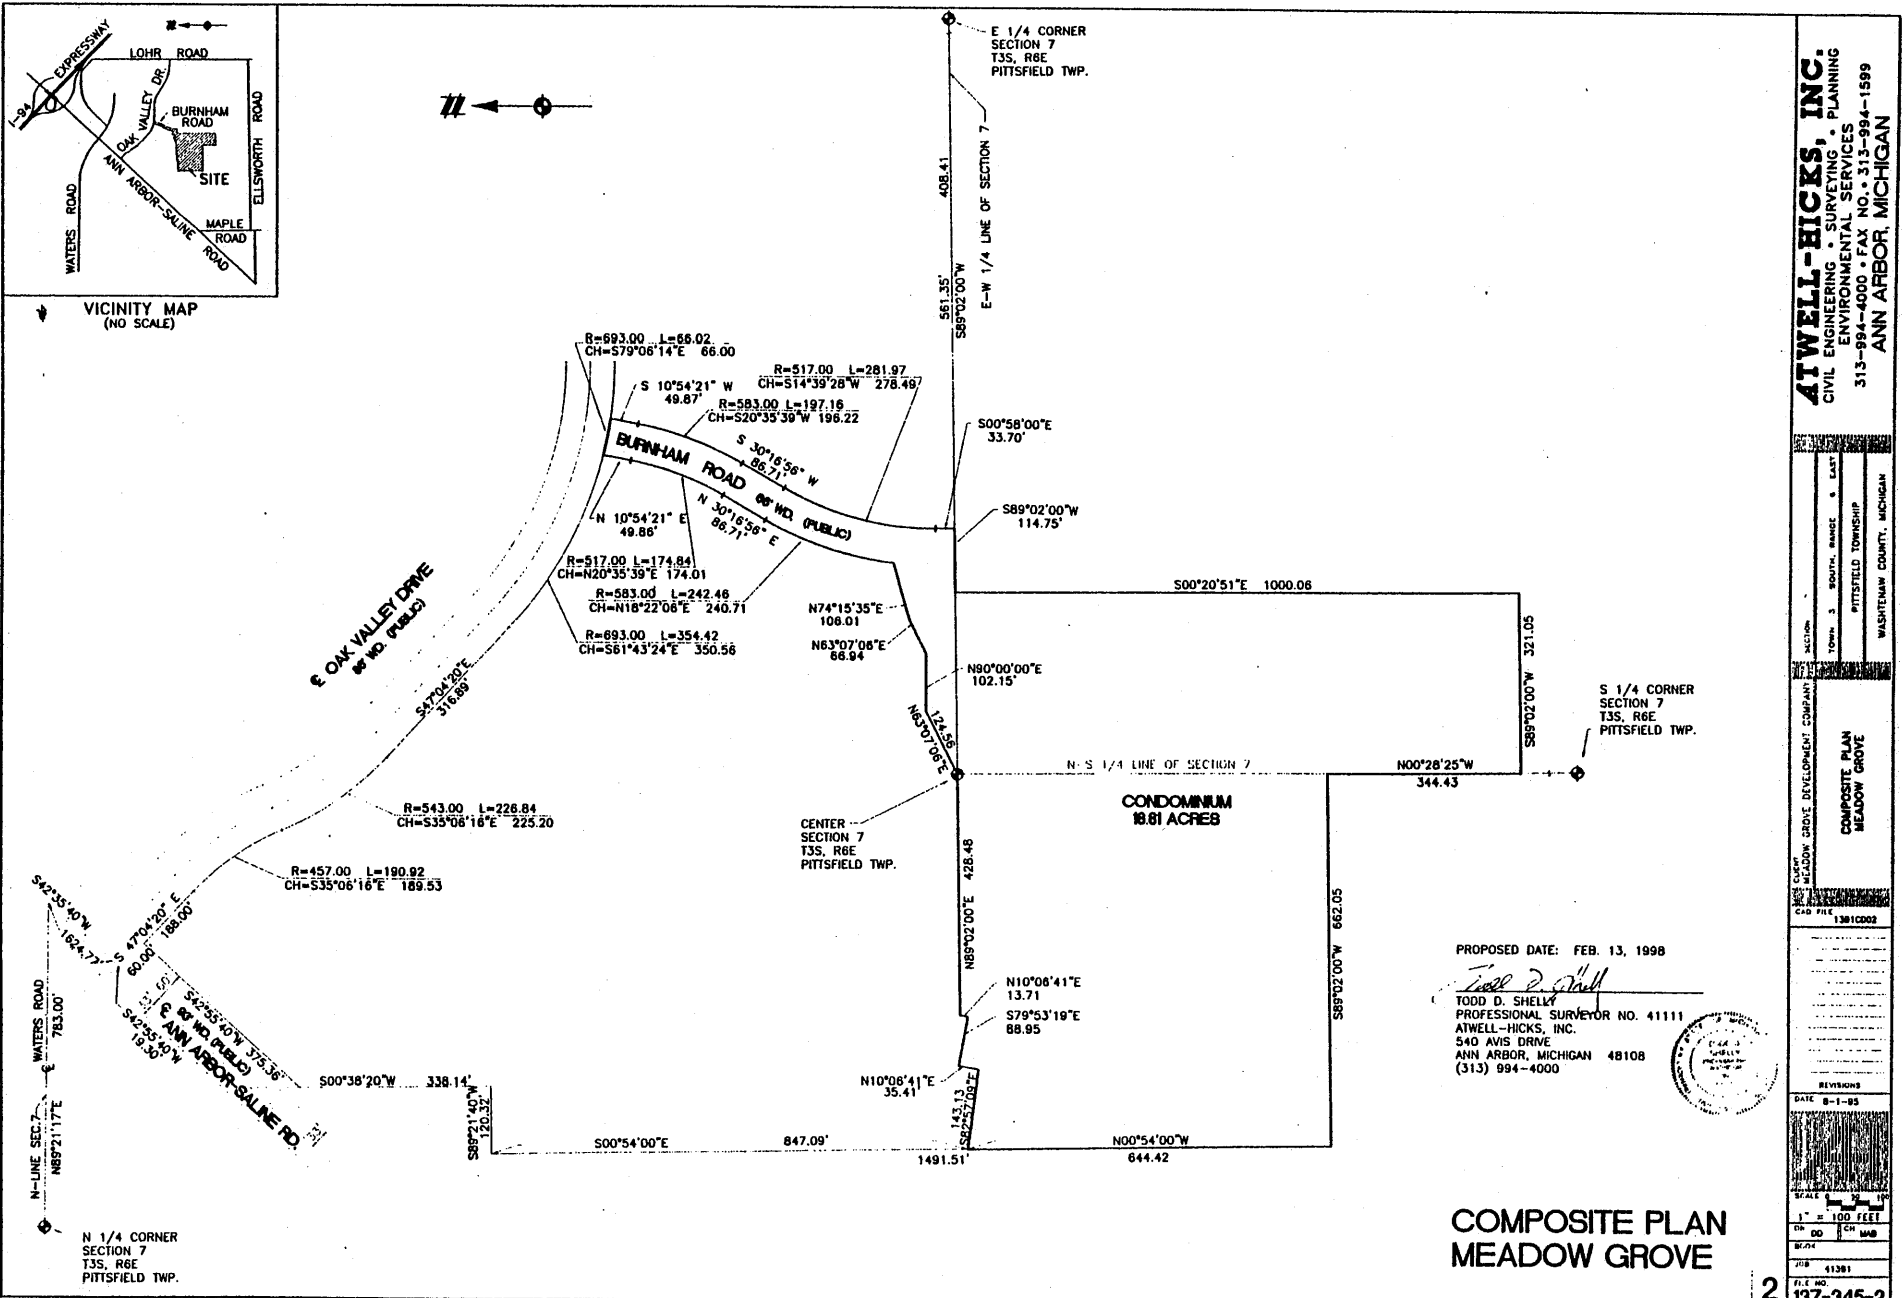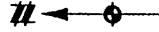

PROPOSED DATE: FEB. 13, 1998

Todd D. Shelly
 TODD D. SHELLEY
 PROFESSIONAL SURVEYOR NO. 41111
 ATWELL-HICKS, INC.
 540 AVIS DRIVE
 ANN ARBOR, MICHIGAN 48108
 (313) 994-4000



ATWELL-HICKS, INC.
 CIVIL ENGINEERING • SURVEYING • PLANNING
 ENVIRONMENTAL SERVICES
 313-994-4000 • FAX NO. 313-994-1599
 ANN ARBOR, MICHIGAN


PROJECT	MEADOW GROVE DEVELOPMENT COMPANY
TOWN	3
RANGE	6 EAST
COUNTY	PITTSFIELD TOWNSHIP
STATE	WASHINGTON COUNTY, MICHIGAN

COMPOSITE PLAN	MEADOW GROVE
CD FILE	1381C002

REVISIONS	DATE
8-1-85	

SCALE	1" = 100 FEET
DATE	8-1-85
JOB	41381
DRAWN	
CHECKED	

**COMPOSITE PLAN
MEADOW GROVE**

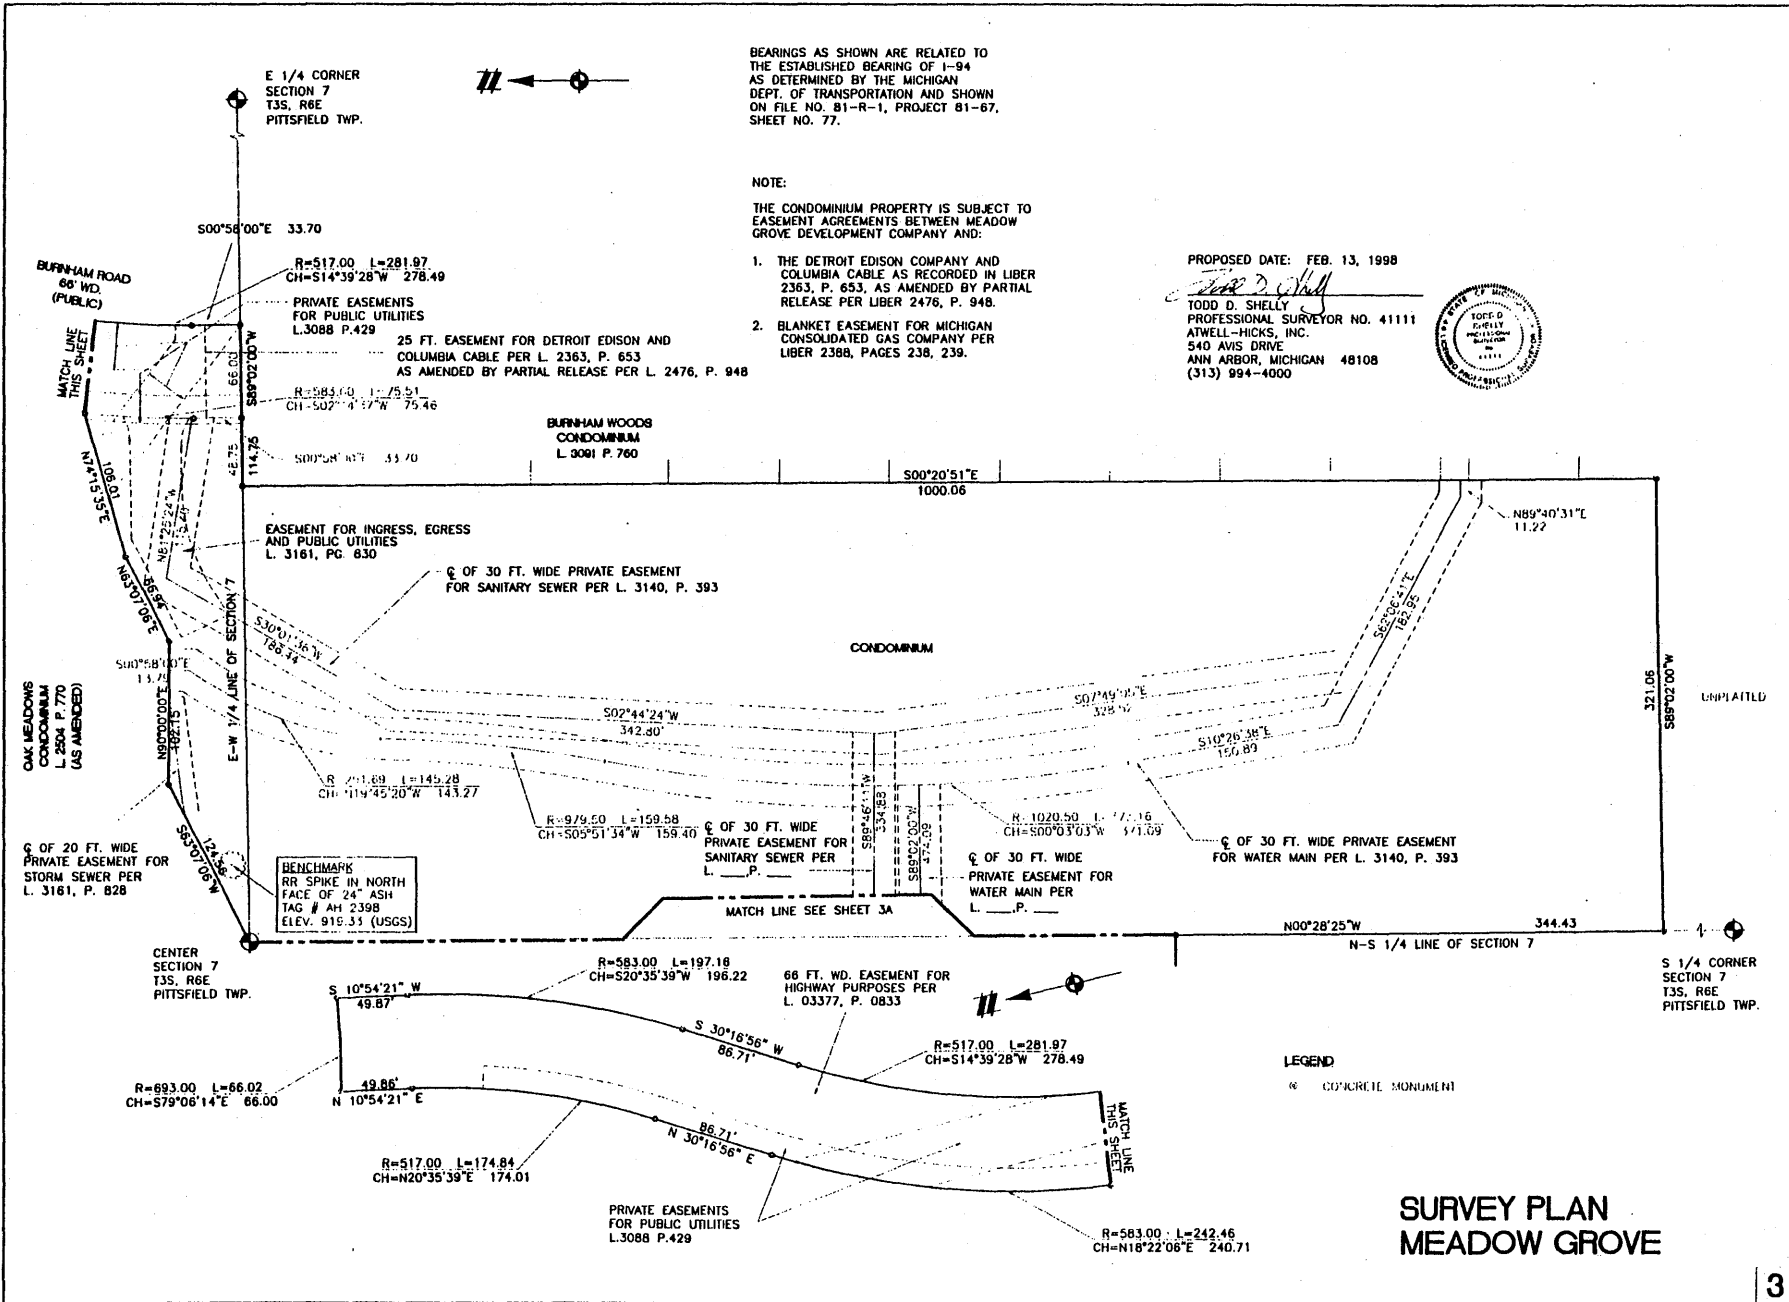

ATWELL-HICKS, INC.
 CIVIL ENGINEERING • SURVEYING • PLANNING
 ENVIRONMENTAL SERVICES
 313-994-4000 • FAX NO. 313-994-1599
 ANN ARBOR, MICHIGAN

SECTION 7
 TOWN 3 SOUTH, RANGE 6 EAST
 PITTSFIELD TOWNSHIP
 WASHTENAW COUNTY, MICHIGAN

SURVEY PLAN
 MEADOW GROVE

REVISIONS

DATE	REVISIONS
8-1-95	

SCALE
 1" = 40 FEET

DR DD
 CC CH
 BY MNE

JOB 41381
 FILE NO 137-345-3

BEARINGS AS SHOWN ARE RELATED TO THE ESTABLISHED BEARING OF I-94 AS DETERMINED BY THE MICHIGAN DEPT. OF TRANSPORTATION AND SHOWN ON FILE NO. 81-R-1, PROJECT 81-67, SHEET NO. 77.



ATWELL-HICKS, INC.
 CIVIL ENGINEERING • SURVEYING • PLANNING
 ENVIRONMENTAL SERVICES
 315-994-4000 • FAX NO. 313-994-1599
 ANN ARBOR, MICHIGAN

SECTION 7
 TOWNSHIP 3 SOUTH, RANGE 6 EAST
 PITTSFIELD TOWNSHIP
 WASHTENAW COUNTY, MICHIGAN

MEADOW GROVE DEVELOPMENT DIST.
 SURVEY PLAN
 MEADOW GROVE




REVISIONS

DATE	REVISIONS

SCALE
 1" = 40 FEET
 DA: [] IN: [] CH: [] TSP: []
 BOOK: []

JOB: 41381
 FILE NO. 137-345-3A

3A

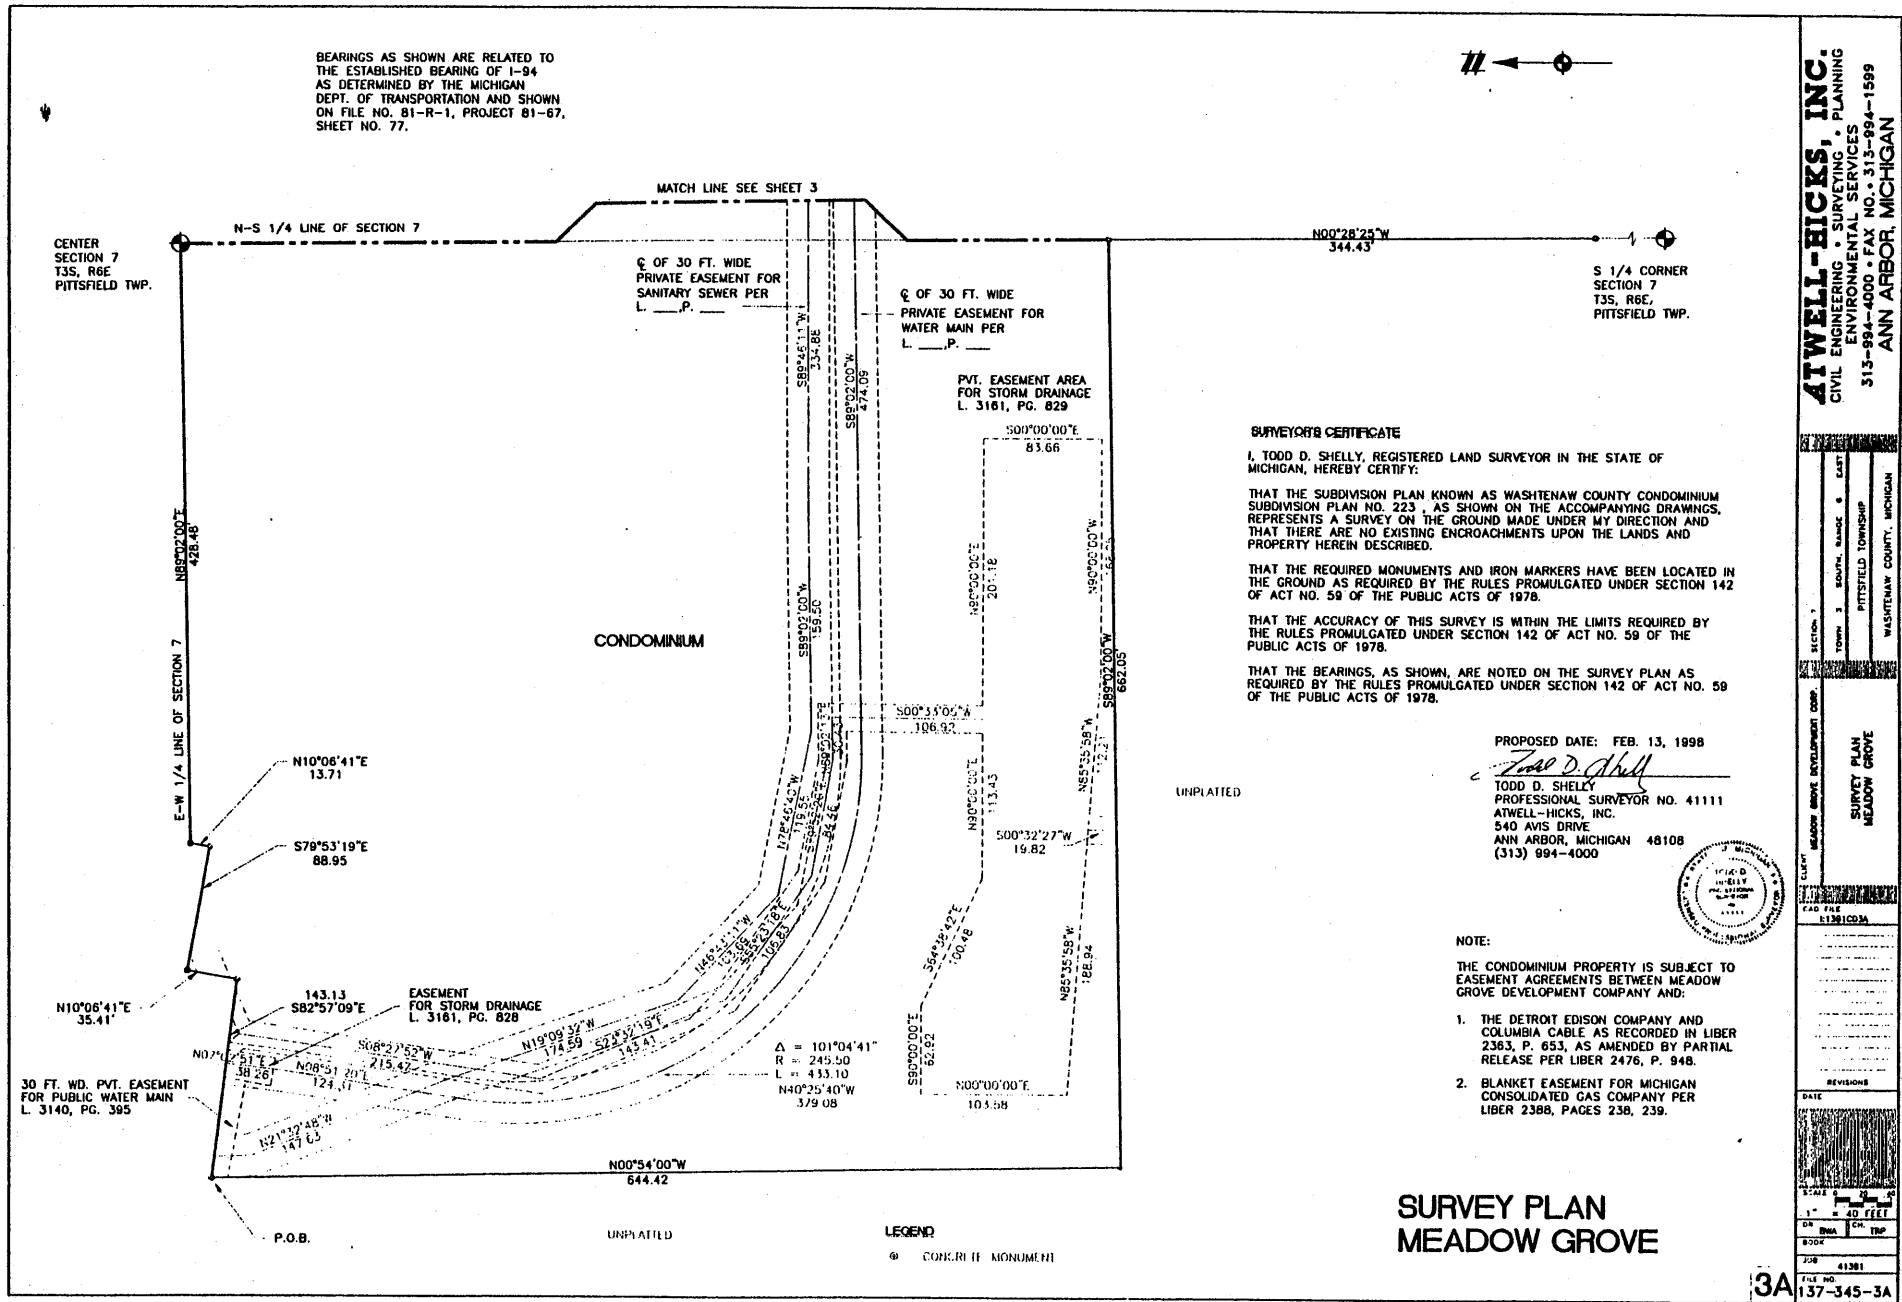

SURVEYOR'S CERTIFICATE

I, TODD D. SHELLY, REGISTERED LAND SURVEYOR IN THE STATE OF MICHIGAN, HEREBY CERTIFY:

THAT THE SUBDIVISION PLAN KNOWN AS WASHTENAW COUNTY CONDOMINIUM SUBDIVISION PLAN NO. 223, AS SHOWN ON THE ACCOMPANYING DRAWINGS, REPRESENTS A SURVEY ON THE GROUND MADE UNDER MY DIRECTION AND THAT THERE ARE NO EXISTING ENCROACHMENTS UPON THE LANDS AND PROPERTY HEREIN DESCRIBED.

THAT THE REQUIRED MONUMENTS AND IRON MARKERS HAVE BEEN LOCATED IN THE GROUND AS REQUIRED BY THE RULES PROMULGATED UNDER SECTION 142 OF ACT NO. 59 OF THE PUBLIC ACTS OF 1978.

THAT THE ACCURACY OF THIS SURVEY IS WITHIN THE LIMITS REQUIRED BY THE RULES PROMULGATED UNDER SECTION 142 OF ACT NO. 59 OF THE PUBLIC ACTS OF 1978.

THAT THE BEARINGS, AS SHOWN, ARE NOTED ON THE SURVEY PLAN AS REQUIRED BY THE RULES PROMULGATED UNDER SECTION 142 OF ACT NO. 59 OF THE PUBLIC ACTS OF 1978.

PROPOSED DATE: FEB. 13, 1998

Todd D. Shelly
 TODD D. SHELLY
 PROFESSIONAL SURVEYOR NO. 41111
 ATWELL-HICKS, INC.
 540 AVIS DRIVE
 ANN ARBOR, MICHIGAN 48108
 (313) 994-4000

UNPLATTED

NOTE:


THE CONDOMINIUM PROPERTY IS SUBJECT TO EASEMENT AGREEMENTS BETWEEN MEADOW GROVE DEVELOPMENT COMPANY AND:

1. THE DETROIT EDISON COMPANY AND COLUMBIA CABLE AS RECORDED IN LIBER 2363, P. 653, AS AMENDED BY PARTIAL RELEASE PER LIBER 2476, P. 948.
2. BLANKET EASEMENT FOR MICHIGAN CONSOLIDATED GAS COMPANY PER LIBER 2388, PAGES 238, 239.

**SURVEY PLAN
 MEADOW GROVE**

LEGEND

⊙ CONCRETE MONUMENT

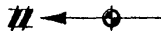


COORDINATE POINT NO.	NORTHING	EASTING
1	3507.507	5352.677
2	3563.826	5463.775
3	3563.826	5565.928
4	3594.095	5625.638
5	3622.851	5727.668
6	3548.595	5790.046
7	DELETED	DELETED
8	3512.964	5675.882
9	2512.918	5681.948
10	2507.501	5360.943
11	2851.923	5358.096
12	3156.874	5403.290
13	3278.238	5415.796
14	3301.440	5422.959
15	3392.949	5432.531
16	3423.516	5429.279
17	3540.913	5462.499
18	3474.998	5622.885

COORDINATE POINT NO.	NORTHING	EASTING
19	3352.843	5597.134
20	3325.224	5594.436
21	3204.540	5576.521
22	3178.136	5575.174
23	3053.372	5570.806
24	3030.629	5573.760
25	2909.777	5590.498
26	2882.024	5585.518
27	2762.058	5607.738
28	2626.521	5612.940
29	2602.162	5493.390
30	2732.857	5445.261
31	2852.528	5421.502
32	2880.497	5406.280
33	3001.398	5389.893
60	3514.900	5790.615
61	3818.018	5860.516
62	3892.896	5904.240


COORDINATE POINT NO.	NORTHING	EASTING
63	4076.578	5973.260
64	4125.545	5982.695
65	4138.021	5917.885
66	4089.065	5908.452
67	3926.177	5847.246
68	3851.299	5803.522

FIRST FLOOR ELEVATION SCHEDULE	
UNIT NO.	FIRST FLOOR ELEVATION
1 - 2	916.95
3 - 4	918.28
5 - 6	917.58
7 - 8	916.25
9 - 12	918.48
13 - 15	919.08
16 - 17	915.68
18 - 19	914.35
20 - 21	916.45
22 - 23	917.78
24 - 25	912.48
26 - 27	911.15
28 - 29	911.40
30 - 31	912.73
32 - 33	908.28
34 - 37	906.95
38 - 39	908.28
40 - 43	906.45


BURNHAM ROAD

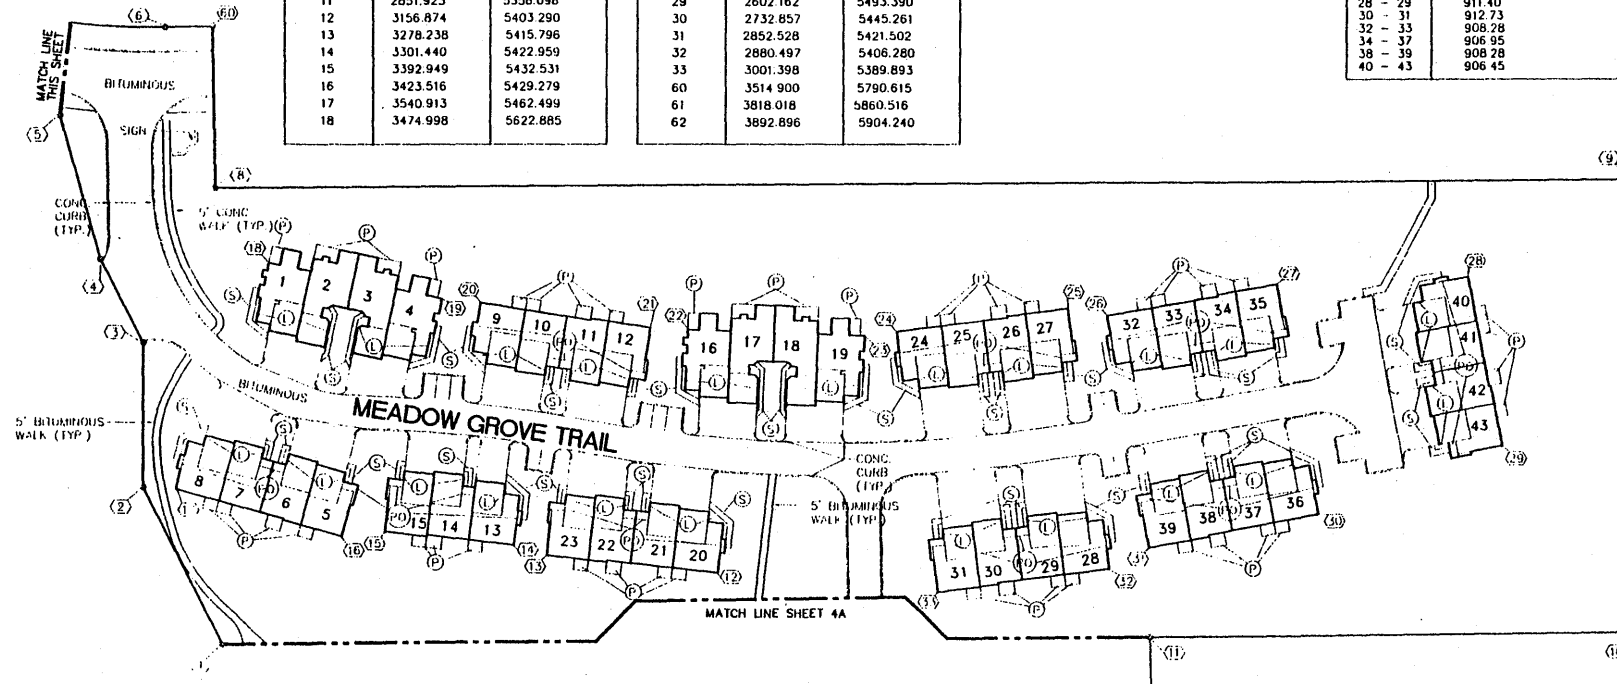

- LEGEND**
- (C4) COORDINATE POINT NO.
 - (P) PATIO/DECK
 - (1-10) PORCH
 - (S) SIDEWALK
 - (L) LANDSCAPING STRIP
 - (C) CONCRETE MONUMENT
 - MBH MUST BE BUILT
 - [Hatched Box] LIMITED COMMON ELEMENT
 - [Dotted Box] GENERAL COMMON ELEMENT

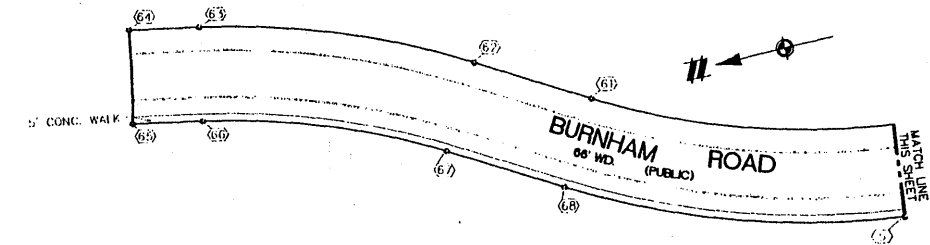

AS-BUILT DATE: FEB. 13, 1998
 Todd Pascoe
 TODD PASCOE
 PROFESSIONAL ENGINEER NO. 36125
 ATWELL-HICKS, INC.
 540 AVIS DRIVE
 ANN ARBOR, MICHIGAN 48108
 (313) 994-4000

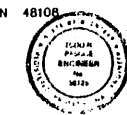

**SITE PLAN
 MEADOW GROVE**

ATWELL-HICKS, INC.
 CIVIL ENGINEERING • SURVEYING • PLANNING
 ENVIRONMENTAL SERVICES
 313-994-4000 • FAX NO. 313-994-1999
 ANN ARBOR, MICHIGAN

PROJECT: MEADOW GROVE DEVELOPMENT COMPANY
 SHEET: SITE PLAN MEADOW GROVE
 DATE: 8-1-85
 SCALE: 1" = 40 FEET
 DRAWN BY: [Name]
 CHECKED BY: [Name]
 TITLE NO: 137-345-4

ATWELL-HICKS, INC.
 CIVIL ENGINEERING • SURVEYING • PLANNING
 ENVIRONMENTAL SERVICES
 313-994-4000 • FAX NO. 313-994-1999
 ANN ARBOR, MICHIGAN


SECTION 7
 TOWN 3 SOUTH, RANGE 6 EAST
 PITTSFIELD TOWNSHIP
 WASHTENAW COUNTY, MICHIGAN

MEADOW GROVE DEVELOPMENT COMPANY
 SITE PLAN
 MEADOW GROVE

40 FILE
 1381CD4A

REVISIONS

DATE 8-1-95
 SCALE 1" = 40 FEET
 DRAWN DD
 CHECK MAB
 PLOTTED
 FILE NO. 41381

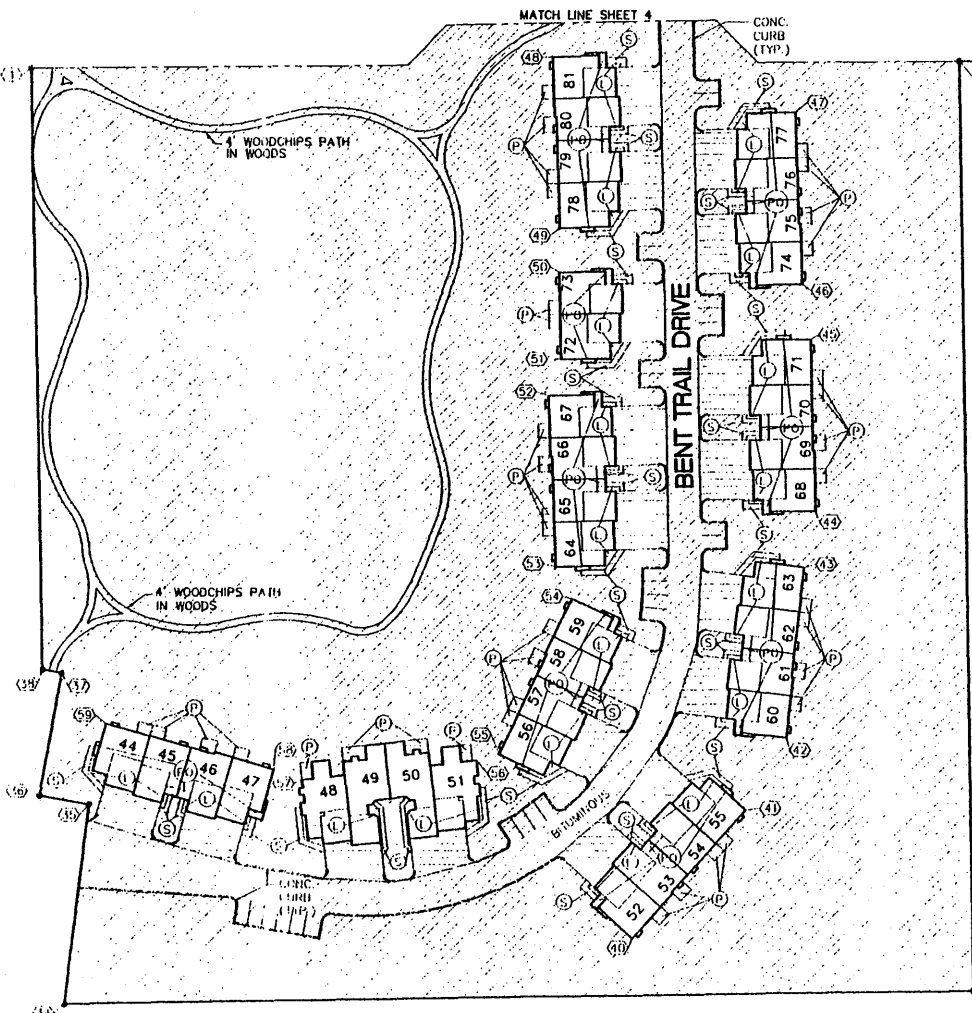

COORDINATE POINT NO.	NORTHING	EASTING
1	3507.507	5352.677
10	2507.501	5360.943
11	2851.923	5358.096
34	3485.098	4686.018
35	3467.537	4828.062
36	3502.397	4834.279
37	3486.781	4921.847
38	3500.278	4924.254
39	2840.754	4696.140
40	3083.383	4732.804
41	3002.665	4824.292
42	2973.848	4876.132
43	2961.178	4997.478
44	2953.215	5037.784
45	2956.606	5159.743
46	2962.802	5199.415
47	2967.895	5321.315
48	3139.954	5360.624


COORDINATE POINT NO.	NORTHING	EASTING
49	3134.684	5238.732
50	3135.174	5207.352
51	3133.982	5145.363
52	3142.705	5119.376
53	3137.894	4997.464
54	3176.488	4974.939
55	3177.634	4864.170
56	3193.695	4859.652
57	3317.781	4845.951
58	3337.648	4853.459
59	3455.254	4885.931

UNIT NO.	FIRST FLOOR ELEVATION
44 - 45	918.01
46 - 47	916.68
48 - 49	913.71
50 - 51	912.38
52 - 53	911.58
54 - 55	910.25
56 - 57	911.01
58 - 59	909.68
60 - 61	909.91
61 - 62	908.56
64 - 65	909.05
66 - 67	910.38
68 - 69	908.65
70 - 71	909.98
72 - 73	911.58
74 - 75	911.45
76 - 77	912.78
78 - 79	912.75
80 - 81	914.08


- LEGEND**
- (24) COORDINATE POINT NO.
 - (P) PATIO/DECK
 - (PO) PORCH
 - (S) SIDEWALK
 - (L) LANDSCAPING STRIP
 - (C) CONCRETE MONUMENT
 - M.B.H. MUST BE BUILT
 - [Hatched Box] LIMITED COMMON ELEMENT
 - [Dotted Box] GENERAL COMMON ELEMENT

PROPOSED DATE: FEB. 13, 1998

TODD PASCOE
 PROFESSIONAL ENGINEER NO. 36125
 ATWELL-HICKS, INC.
 540 AVIS DRIVE
 ANN ARBOR, MICHIGAN 48106
 (313) 994-4000

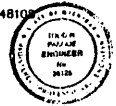


**SITE PLAN
 MEADOW GROVE**

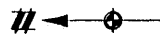

EXISTING	
4	STORM
4	SANITARY
4	WATER
4	OVERHEAD ELECTRIC
4	UNDERGROUND TELEPHONE
9	GAS
○	MANHOLE
□	CATCH BASIN
●	HYDRANT
⊙	POWER POLE
●	VALVE IN WELL


LEGEND:

EXISTING	
— R —	STORM
— S —	SANITARY
— W —	WATER
— E —	UNDERGROUND ELECTRIC
— T —	UNDERGROUND TELEPHONE
— C —	UNDERGROUND TV CABLE
— G —	GAS
●	MANHOLE OR CATCH BASIN
●	HYDRANT
●	VALVE IN WELL
□	WATER LEAD STOP BOX
⊙	TRANSFORMER
⊙	GAS METER LOCATION
⊙	ELECTRIC METER LOCATION
⊙	WATER METER LOCATION

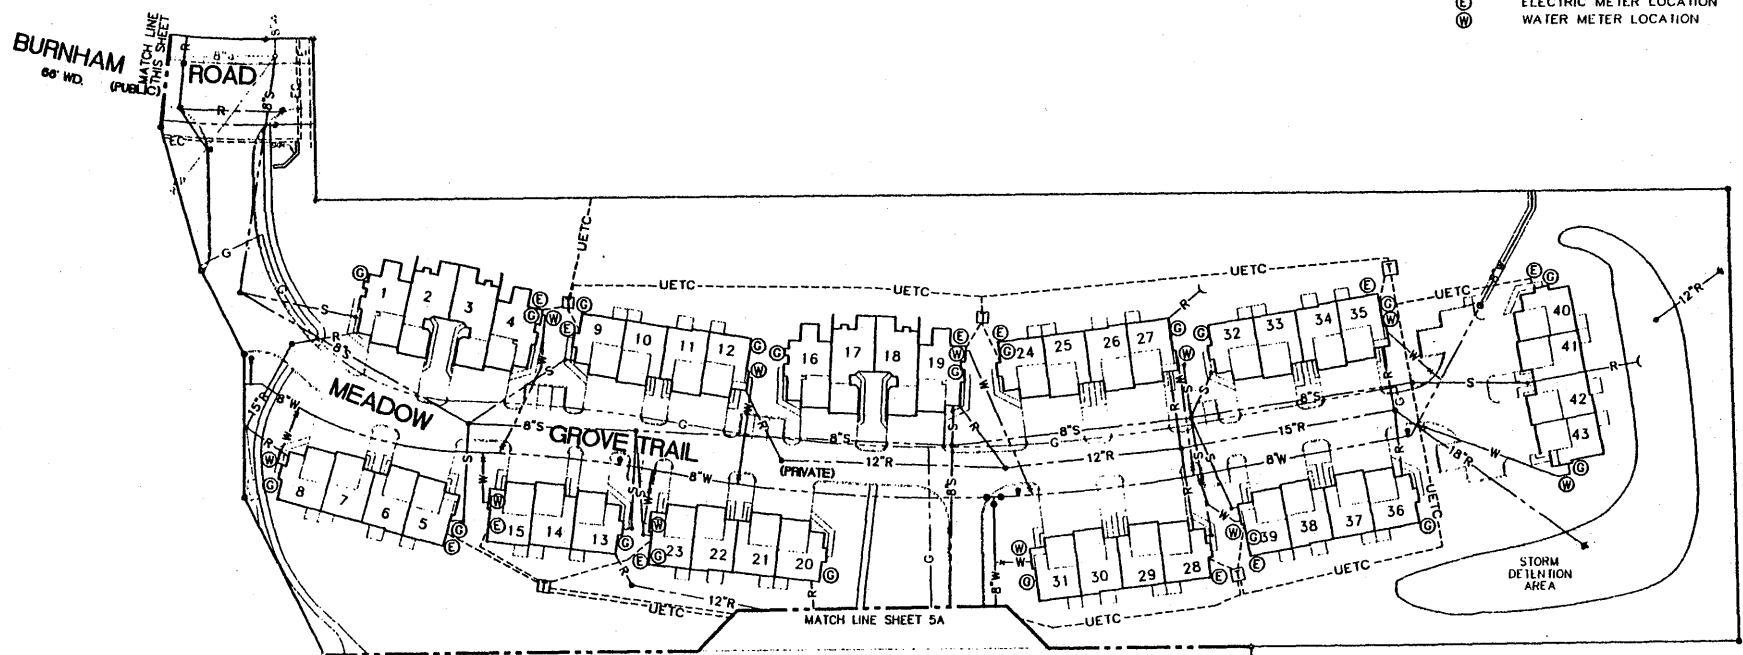

NOTES:

- ALL UNITS WILL BE SERVICED WITH SANITARY SEWER AND WATER BY PITTSFIELD TOWNSHIP. INFORMATION AS SHOWN OBTAINED FROM APPROVED CONSTRUCTION PLANS.
- ALL UNITS WILL BE SERVICED WITH POWER BY THE DETROIT EDISON COMPANY. ALL UNITS WILL BE SERVICED WITH TELEPHONE BY THE AMERITECH CORPORATION. ALL UNITS WILL BE SERVICED WITH CABLEVISION BY THE CONTINENTAL CABLEVISION OF MICHIGAN. POWER, TELEPHONE AND CABLEVISION LINES AS SHOWN OBTAINED FROM DETROIT EDISON COMPANY PLANS.
- ALL UNITS WILL BE SERVICED WITH GAS BY THE MICHIGAN CONSOLIDATED GAS COMPANY. INFORMATION AS SHOWN OBTAINED FROM MICHIGAN CONSOLIDATED GAS COMPANY CONSTRUCTION PLANS.
- STORM SLEWER LOCATIONS SHOWN ARE OBTAINED FROM APPROVED CONSTRUCTION PLANS.
- UTILITY METER LOCATIONS FOR EACH BUILDING WILL BE SHOWN ON THE "AS-BUILT" CONDOMINIUM PLANS.
- ALL SANITARY LEADS ARE 6". ALL STORM LEADS ARE 6". ALL WATER LEADS ARE 1-1/2". ALL GAS LEADS ARE 7/8".

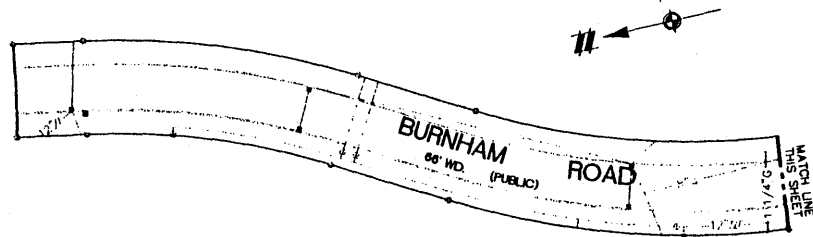

AS-BUILT DATE: FEB. 13, 1998

Todd Pascoe
 TODD PASCOE
 PROFESSIONAL ENGINEER NO. 36125
 ATWELL-HICKS, INC.
 540 AVIS DRIVE
 ANN ARBOR, MICHIGAN 48108
 (313) 994-4000



UTILITY PLAN
 MEADOW GROVE

ATWELL-HICKS, INC.
 CIVIL ENGINEERING • SURVEYING • PLANNING
 ENVIRONMENTAL SERVICES
 313-994-4000 • FAX NO. 313-994-1899
 ANN ARBOR, MICHIGAN

SECTION 7
 TOWNSHIP SOUTH, RANGE 8 EAST
 PITTSFIELD TOWNSHIP
 WASHINGTON COUNTY, MICHIGAN

UTILITY PLAN
 MEADOW GROVE

13810000

REVISIONS


DATE 8-1-95

SCALE 1" = 40 FEET

BOOK

SHEET 5

137-345-5

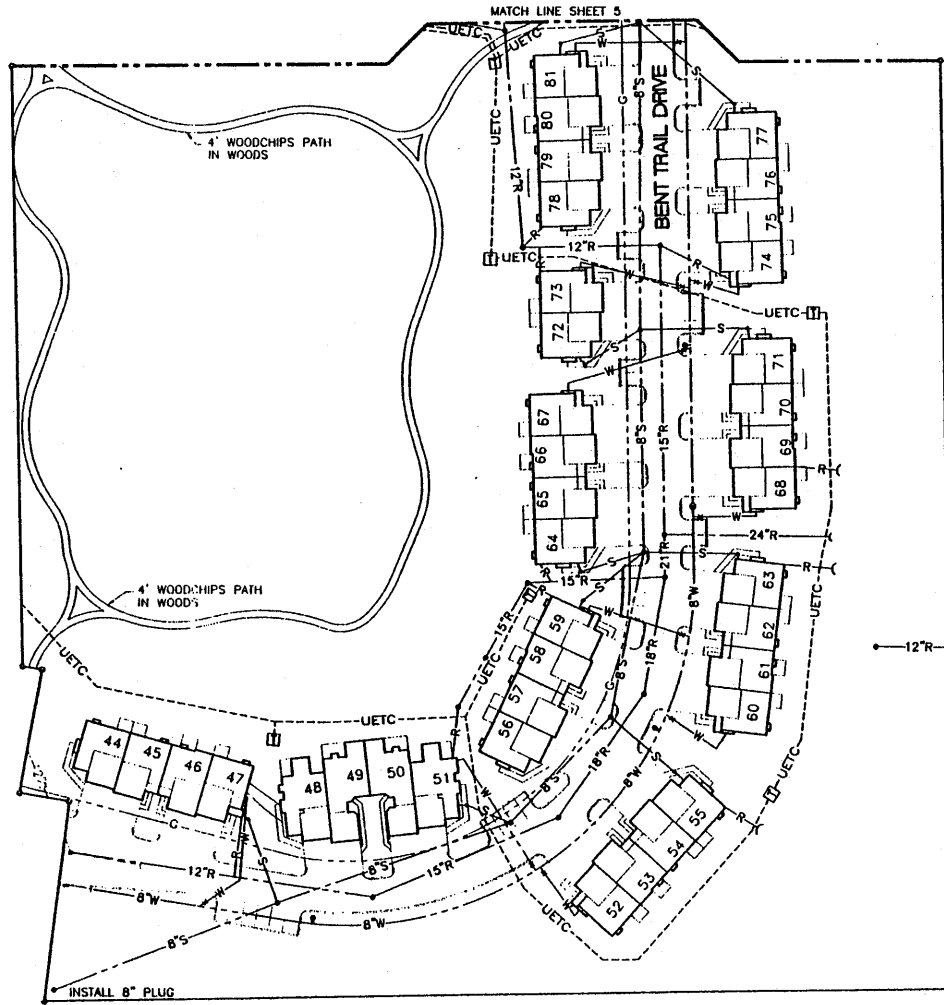

EXISTING	
7	STORM
3	SANITARY
12	WATER
1	OVERHEAD ELECTRIC
1	UNDERGROUND TELEPHONE
9	GAS
□	MANHOLE
□	CATCH BASIN
○	FEDRANT
○	POWER POLE
○	VALVE IN WELL

LEGEND:		PROPOSED	
---	R	---	STORM
---	S	---	SANITARY
---	W	---	WATER
---	E	---	UNDERGROUND ELECTRIC
---	T	---	UNDERGROUND TELEPHONE
---	C	---	UNDERGROUND TV CABLE
○		○	GAS
○		○	MANHOLE OR CATCH BASIN
○		○	HYDRANT
○		○	VALVE IN WELL
○		○	WATER LEAD STOP BOX
□		□	TRANSFORMER



PROPOSED DATE: FEB. 13, 1998
 Todd Pascoe
 PROFESSIONAL ENGINEER NO. 36125
 ATWELL-HICKS, INC.
 540 AVIS DRIVE
 ANN ARBOR, MICHIGAN 48108
 (313) 994-4000

UTILITY PLAN MEADOW GROVE

- NOTES:
- ALL UNITS WILL BE SERVICED WITH SANITARY SEWER AND WATER BY PITTSFIELD TOWNSHIP. INFORMATION AS SHOWN OBTAINED FROM APPROVED CONSTRUCTION PLANS.
 - ALL UNITS WILL BE SERVICED WITH POWER BY THE DETROIT EDISON COMPANY. ALL UNITS WILL BE SERVICED WITH TELEPHONE BY THE AMERITECH CORPORATION. ALL UNITS WILL BE SERVICED WITH CABLEVISION BY THE CONTINENTAL CABLEVISION OF MICHIGAN. POWER, TELEPHONE AND CABLEVISION LINES AS SHOWN OBTAINED FROM DETROIT EDISON COMPANY PLANS.
 - ALL UNITS WILL BE SERVICED WITH GAS BY THE MICHIGAN CONSOLIDATED GAS COMPANY. INFORMATION AS SHOWN OBTAINED FROM MICHIGAN CONSOLIDATED GAS COMPANY CONSTRUCTION PLANS.
 - STORM SEWER LOCATIONS SHOWN ARE OBTAINED FROM APPROVED CONSTRUCTION PLANS.
 - UTILITY METER LOCATIONS FOR EACH BUILDING WILL BE SHOWN ON THE "AS-BUILT" CONDOMINIUM PLANS.
 - ALL SANITARY LEADS ARE 6". ALL STORM LEADS ARE 6". ALL WATER LEADS ARE 1-1/2". ALL GAS LEADS ARE 7/8".


ATWELL-HICKS, INC.
 CIVIL ENGINEERING • SURVEYING • PLANNING
 ENVIRONMENTAL SERVICES
 313-994-4000 • FAX NO. 313-994-1599
 ANN ARBOR, MICHIGAN

SECTION 1
 SHEET 3 OF 3
 PROJECT: MEADOW GROVE
 TOWNSHIP: PITTSFIELD TOWNSHIP
 COUNTY: WASHTENAW COUNTY, MICHIGAN

PROJECT: MEADOW GROVE DEVELOPMENT COMPANY
 CAD FILE: 137100A

REVISIONS	DATE
	8-1-95


SCALE: 1" = 40 FEET
 SHEET NO. 41391
 FILE NO. 137-345-5A

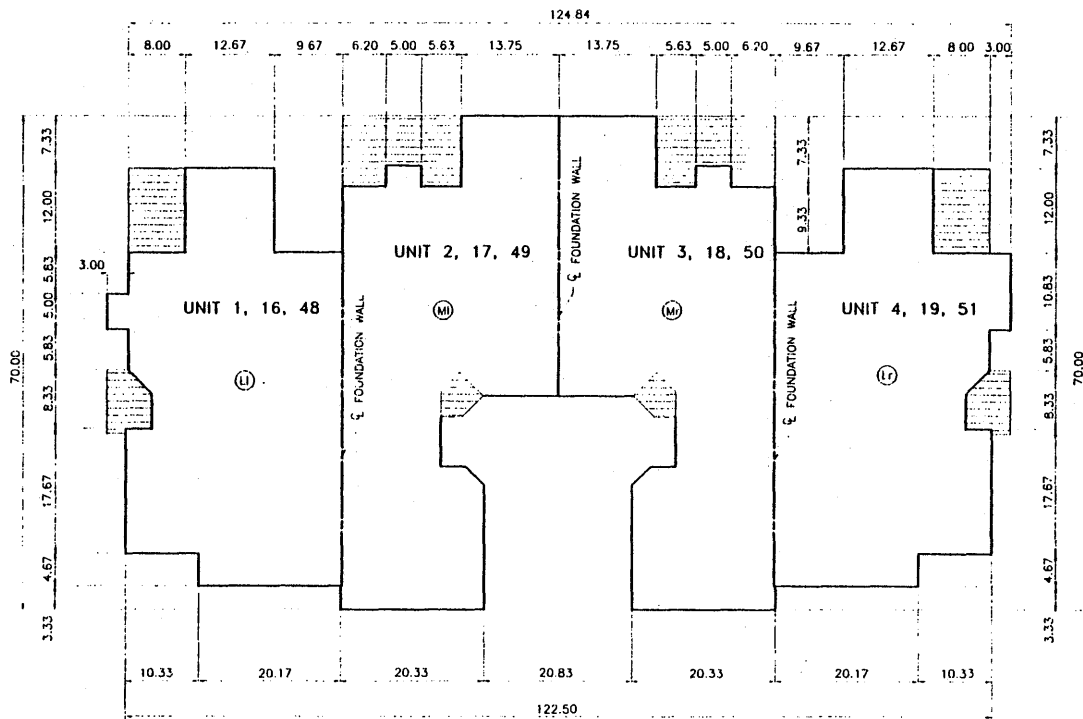

BUILDING TYPE 1

LEGEND
 LIMITED COMMON ELEMENT

- NOTE:**
1. FOR LIMITS OF OWNERSHIP SEE FLOOR PLANS FOR INDIVIDUAL UNITS.
 2. DIMENSIONS SHOWN ARE TO OUTSIDE OF FOUNDATION WALL.
 3. UNITS 5-8 HAVE BEEN BUILT. ALL OTHER UNITS NEED NOT BE BUILT.

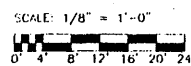

PROPOSED DATE - FEB. 13, 1998
T. Pascoe
 TODD PASCOE
 LICENSED PROFESSIONAL ENGINEER
 NO. 36125
 ATWELL-HICKS, INC.
 540 AVIS DRIVE
 ANN ARBOR, MICHIGAN 48108
 TELEPHONE - (313) 994-4000



**BUILDING TYPE 1
 MEADOW GROVE**

6

ATWELL-HICKS, INC.
 CIVIL ENGINEERING • SURVEYING • PLANNING
 ENVIRONMENTAL SERVICES
 313-994-4000 • FAX NO. 313-994-1599
 ANN ARBOR, MICHIGAN


SECTION 7
 TOWNSHIP 3 SOUTH, RANGE 6 EAST
 PITSFIELD TOWNSHIP
 WASHTENAW COUNTY, MICHIGAN

MEADOW GROVE DEVELOPMENT COMPANY
 BUILDING TYPE 1
 MEADOW GROVE
 CAD FILE 1316008


REVISIONS
DATE 8-1-83

TR 2 m 2 SIK 2W
 DTGN
 JOB 41381
 FILE NO 137-345-6

UNIT "Lr"		
UNIT NO.	BUILDING TYPE	PAGE NO.
4,51	1	6
19	1	6

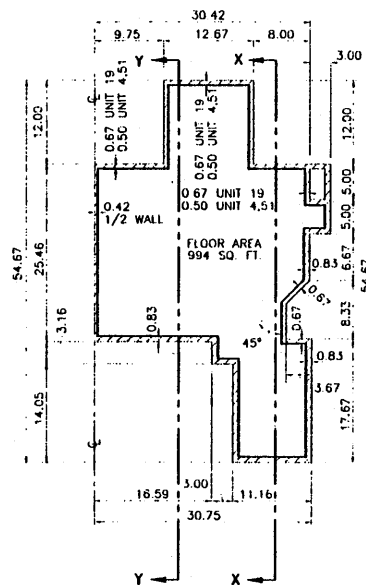
 


FOUNDATION PLAN

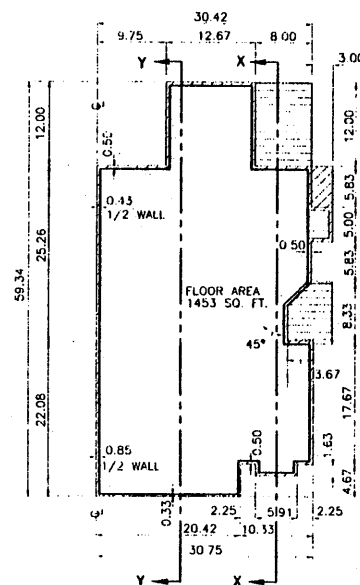


FLOOR PLAN

LEGEND

-  LIMITED COMMON ELEMENT
-  GENERAL COMMON ELEMENT
- LIMITS OF OWNERSHIP, OWNERSHIP LINES ARE 90° TO EACH OTHER UNLESS SHOWN OTHERWISE

NOTE: UNITS 5-8 MUST BE BUILT.
ALL OTHER UNITS NEED NOT BE BUILT.

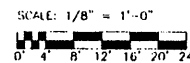

PROPOSED DATE - FEB 13, 1998

T. Pascoe
TODD PASCOE
LICENSED PROFESSIONAL ENGINEER
NO. 36125
ATWELL-HICKS, INC.
540 AVIS DRIVE
ANN ARBOR, MICHIGAN 48108
TELEPHONE - (313) 994 4000



ATWELL-HICKS, INC.
CIVIL ENGINEERING • SURVEYING • PLANNING
ENVIRONMENTAL SERVICES
313-994-4000 • FAX NO. 313-994-1599
ANN ARBOR, MICHIGAN


SECTION 7	TOWN 3	SOUTH RANGE 6	DAY
PLAT FILE	PITTSFIELD TOWNSHIP		
INDEX	WASHTENAW COUNTY, MICHIGAN		

"Lr" FLOOR PLAN
MEADOW GROVE


DATE	BY	REVISIONS

DATE	BY	CHK	BY
JOB	41391		
FILE NO.	137-345-7		

UNIT "LI"		
UNIT NO.	BUILDING TYPE	PAGE NO.
1,48	1	6
16	1	6

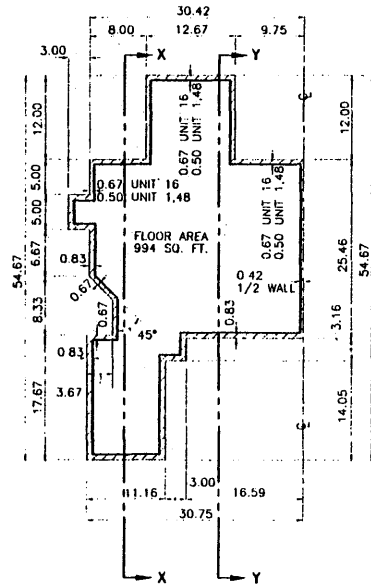


FOUNDATION PLAN

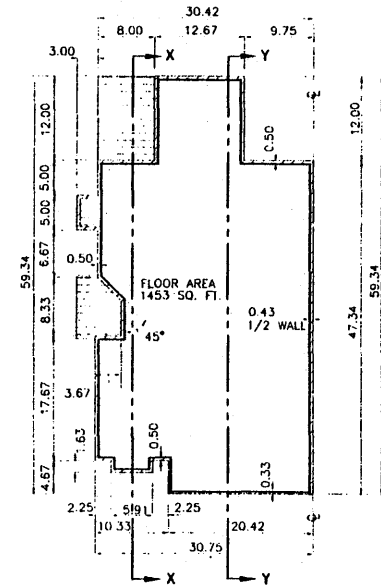

FLOOR PLAN

LEGEND

LIMITED COMMON ELEMENT
 GENERAL COMMON ELEMENT
 LIMITS OF OWNERSHIP. OWNERSHIP LINES ARE 90° TO EACH OTHER UNLESS SHOWN OTHERWISE
 NOTE: UNITS 5-8 MUST BE BUILT. ALL OTHER UNITS NEED NOT BE BUILT.

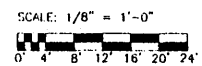

PROPOSED DATE - FEB. 13, 1998

T. Pascoe

TODD PASCOE
 LICENSED PROFESSIONAL ENGINEER
 NO. 36125
 ATWELL-HICKS, INC.
 540 AVIS DRIVE
 ANN ARBOR, MICHIGAN 48108
 TELEPHONE - (313) 994-4000




ATWELL-HICKS, INC.
 CIVIL ENGINEERING • SURVEYING • PLANNING
 ENVIRONMENTAL SERVICES
 313-994-4000 • FAX NO. 313-994-1599
 ANN ARBOR, MICHIGAN

SECTION 7
 TOWN 3 SOUTH, RANGE 6 EAST
 PITTSFIELD TOWNSHIP
 WASHTENAW COUNTY, MICHIGAN


"LI" FLOOR PLAN
 MEADOW GROVE

NO.	DATE	REVISIONS


**"LI" FLOOR PLAN
 MEADOW GROVE**

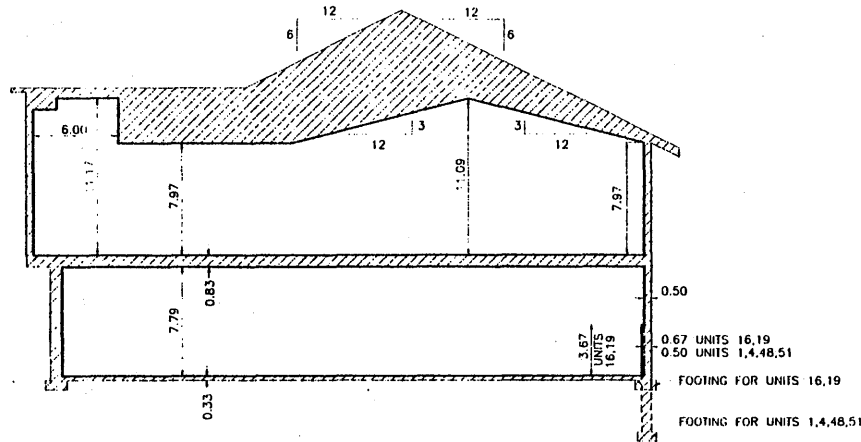

X-X SECTION

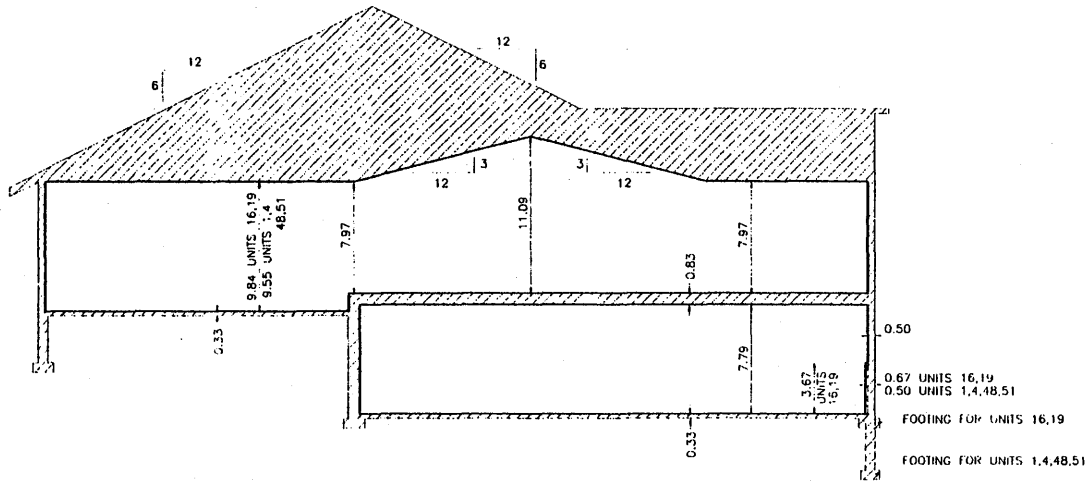

Y-Y SECTION

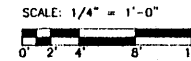

LEGEND

- GENERAL COMMON ELEMENT
- LIMITS OF OWNERSHIP. OWNERSHIP LINES ARE 90° TO EACH OTHER UNLESS SHOWN OTHERWISE
- NOTE: UNITS 5-8 HAVE BEEN BUILT
ALL OTHER UNITS NEED NOT BE BUILT

PROPOSED DATE - FEB. 13, 1998

TLO Pascoe
 TODD PASCOE
 LICENSED PROFESSIONAL ENGINEER
 NO. 36125
 ATWELL-HICKS, INC.
 540 AVIS DRIVE
 ANN ARBOR, MICHIGAN 48108
 TELEPHONE - (313) 994-4000



ATWELL-HICKS, INC.
 CIVIL ENGINEERING • SURVEYING • PLANNING
 ENVIRONMENTAL SERVICES
 313-994-4000 • FAX NO. 313-994-1599
 ANN ARBOR, MICHIGAN



ALCON	MAP
TOWN 3	SOUTH RANGE 6 EAST
PITTSFIELD TOWNSHIP	
WASHTENAW COUNTY, MICHIGAN	

MEADOW GROVE DEVELOPMENT COMPANY
 PLAN "L"
 BUILDING SECTIONS
 MEADOW GROVE

CAD FILE	1581C009
REVISIONS	
DATE	8-1-98
DR	CH
BY	GW
DATE	4-1-91
FILE NO	137-345-9

**PLAN "L" BUILDING SECTIONS
 MEADOW GROVE**

UNIT "Mr"		
UNIT NO.	BUILDING TYPE	PAGE NO.
3.50	1	6
18	1	6

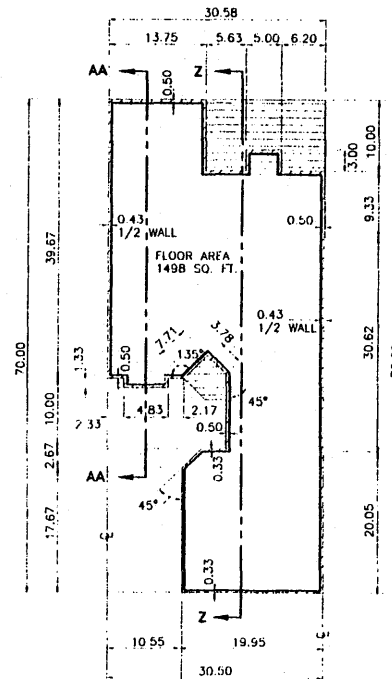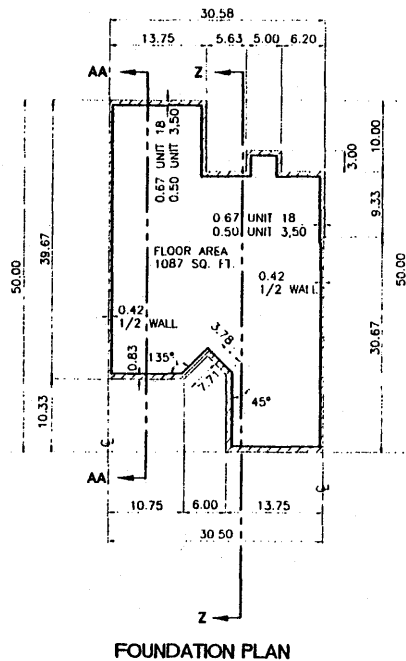

LEGEND




LIMITED COMMON ELEMENT

GENERAL COMMON ELEMENT

LIMITS OF OWNERSHIP. OWNERSHIP LINES ARE 90° TO EACH OTHER UNLESS SHOWN OTHERWISE.

NOTE: UNITS 5-8 MUST BE BUILT.
ALL OTHER UNITS NEED NOT BE BUILT.

SCALE: 1/8" = 1'-0"

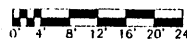

PROPOSED DATE - FEB. 13, 1998

Todd Pascoe
TODD PASCOE
REGISTERED PROFESSIONAL ENGINEER
NO. 36125
ATWELL-HICKS, INC.
540 AVIS DRIVE
ANN ARBOR, MICHIGAN 48108
TELEPHONE - (313) 994-4000



**"Mr" FLOOR PLAN
MEADOW GROVE**

10

ATWELL-HICKS, INC.
CIVIL ENGINEERING • SURVEYING • PLANNING
ENVIRONMENTAL SERVICES
313-994-4000 • FAX NO. 313-994-1599
ANN ARBOR, MICHIGAN


SECTION 7
TOWNSHIP 3 SOUTH, RANGE 6 EAST
PITTSFIELD TOWNSHIP
WASHTENAW COUNTY, MICHIGAN

"Mr" FLOOR PLAN
MEADOW GROVE


MEADOW GROVE DEVELOPMENT COMPANY
7 AD FILE
REVISIONS

DATE 8-11-93
JOB #1181
FILE NO. 137-345-10

UNIT "MI"		
UNIT NO.	BUILDING TYPE	PAGE NO.
2,49	1	6
17	1	6

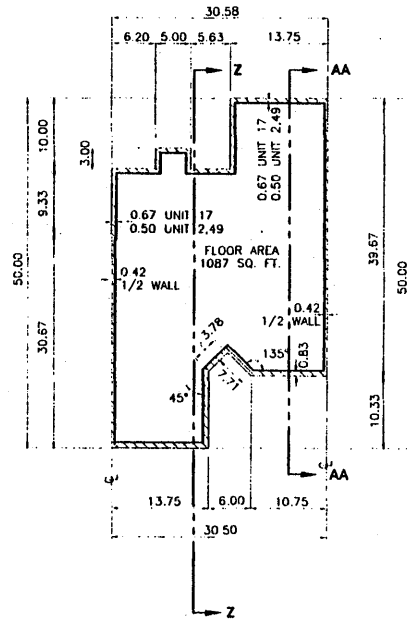
 
 



FOUNDATION PLAN

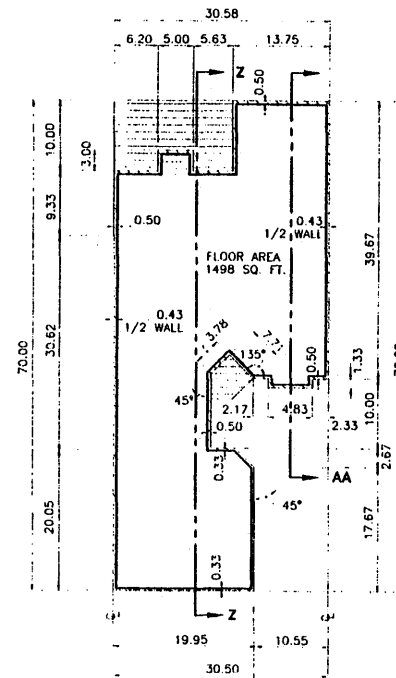

FLOOR PLAN

LEGEND

-  LIMITED COMMON ELEMENT
-  GENERAL COMMON ELEMENT
-  LIMITS OF OWNERSHIP. OWNERSHIP LINES ARE 90° TO EACH OTHER UNLESS SHOWN OTHERWISE
- NOTE: UNITS 5 - 8 MUST BE BUILT. ALL OTHER UNITS NEED NOT BE BUILT.

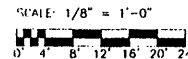

**"MI" FLOOR PLAN
MEADOW GROVE**

PROPOSED DATE - FEB. 13, 1998

Todd Pascoe
TODD PASCOE
LICENSED PROFESSIONAL ENGINEER
NO. 36125
ATWELL-HICKS, INC.
540 AVIS DRIVE
ANN ARBOR, MICHIGAN 48106
TELEPHONE - (313) 994-4000




ATWELL-HICKS, INC.
CIVIL ENGINEERING • SURVEYING • PLANNING
ENVIRONMENTAL SERVICES
313-994-4000 • FAX NO. 313-994-1599
ANN ARBOR, MICHIGAN

SECTION 7
TOWN 2 SOUTH, RANGE 6 EAST
PITTSFIELD TOWNSHIP
WASHTENAW COUNTY, MICHIGAN

MEADOW GROVE DEVELOPMENT COMPANY
"MI" FLOOR PLAN
MEADOW GROVE
LAD FILE


REVISIONS	DATE

DR 4 m 4 CN 04
DOOR
SUB 41291
FILE NO 137-345-11

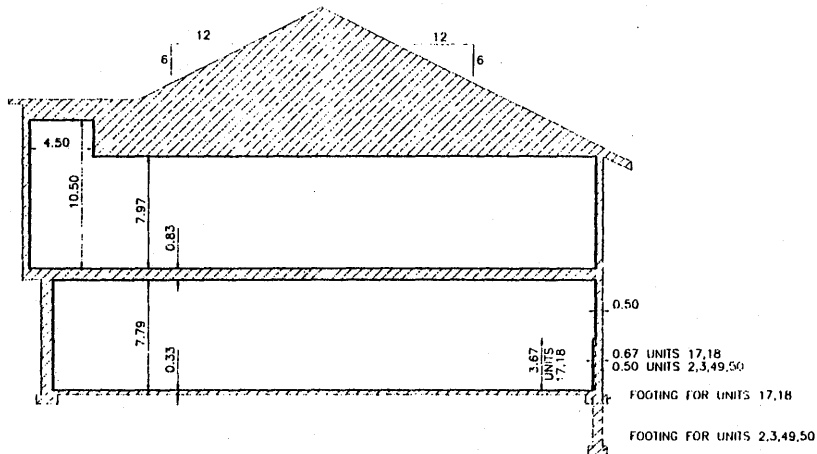


AA-AA SECTION

0.67 UNITS 17,18
 0.50 UNITS 2,3,49,50
 FOOTING FOR UNITS 17,18
 FOOTING FOR UNITS 2,3,49,50

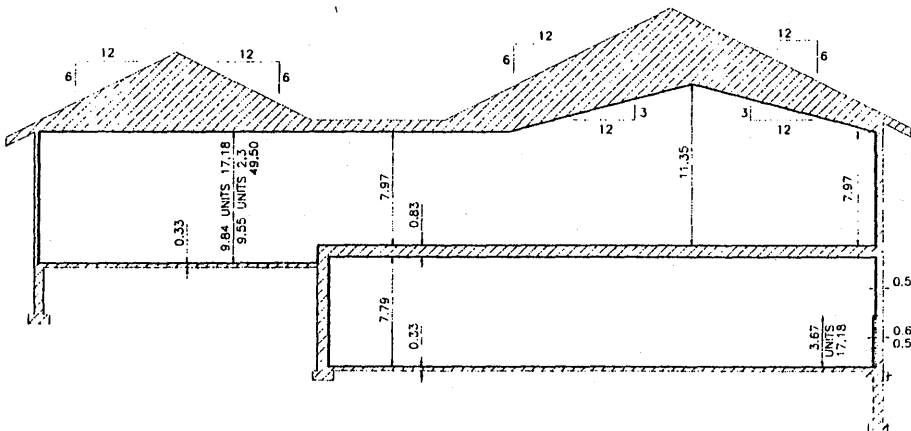



Z-Z SECTION

0.67 UNITS 17,18
 0.50 UNITS 2,3,49,50
 FOOTING FOR UNITS 17,18
 FOOTING FOR UNITS 2,3,49,50

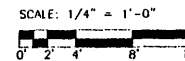

LEGEND

 -  GENERAL COMMON ELEMENT
-  LIMITS OF OWNERSHIP. OWNERSHIP LINES ARE 90° TO EACH OTHER UNLESS SHOWN OTHERWISE
- NOTE: UNITS 5-8 HAVE BEEN BUILT.
ALL OTHER UNITS NEED NOT BE BUILT.

PROPOSED DATE - FEB. 13, 1998

TODD PASCOE
 LICENSED PROFESSIONAL ENGINEER
 NO. 36125
 ATWELL-HICKS, INC.
 540 AVIS DRIVE
 ANN ARBOR, MICHIGAN 48108
 TELEPHONE - (313) 994-4000




ATWELL-HICKS, INC.
 CIVIL ENGINEERING • SURVEYING • PLANNING
 ENVIRONMENTAL SERVICES
 313-994-4000 • FAX NO. • 313-994-1599
 ANN ARBOR, MICHIGAN

SECTION 7
 TOWN 3 SOUTH, RANGE 6 EAST
 PITSFIELD TOWNSHIP
 WASHTENAW COUNTY, MICHIGAN

CLIENT: MEADOW GROVE DEVELOPMENT COMPANY
 PLAN "M"
 BUILDING SECTIONS
 MEADOW GROVE

DATE	8-1-98	
REVISIONS		
NO.	DATE	BY
1	8-1-98	CH
2		
3		
PLAN "M" BUILDING SECTIONS
 MEADOW GROVE

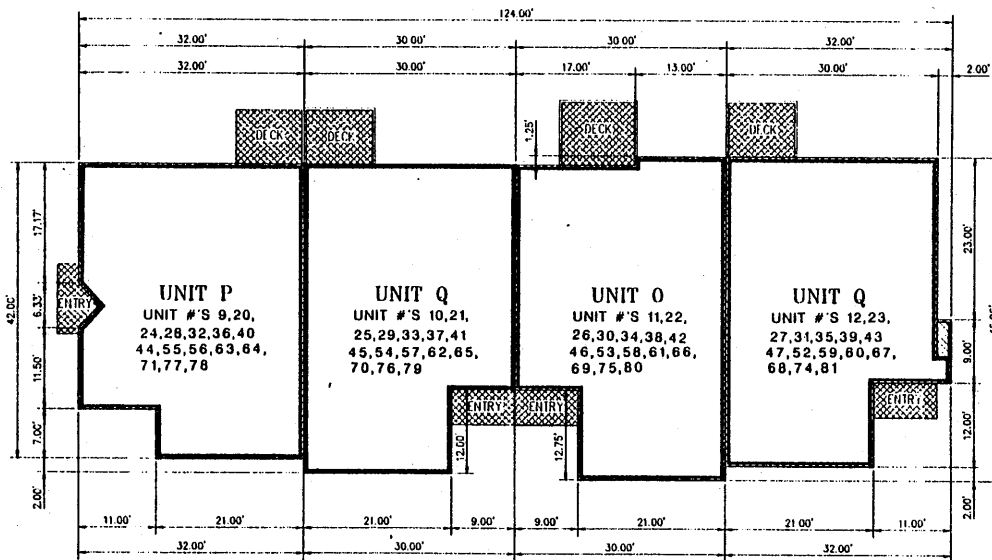

BUILDING TYPE 2

LEGEND

- GENERAL COMMON ELEMENT
- LIMITED COMMON ELEMENT
- LIMITS OF OWNERSHIP
OWNERSHIP LINES ARE 90 DEGREES TO
EACH OTHER UNLESS NOTED OTHERWISE
- ENTRY PORCH

AREAS ARE COMPUTED FROM INTERIOR
DIMENSIONS
ALL WALLS ARE .42 FEET THICK UNLESS
NOTED OTHERWISE
ALL DIMENSIONS ARE IN FEET

SCALE: 1/8" = 1'-0"



J. BRADLEY MOORE
LICENSED ARCHITECT NO. 31784

PROPOSED DATE 08/01/95

J. BRADLEY MOORE & ASSOCIATES
ARCHITECTS INCORPORATED
317 S. DIVISION STREET SUITE 1510
ANN ARBOR, MICHIGAN 48104
(313) 930-1500

UNITS 5-8 HAVE BEEN BUILT
ALL OTHER UNITS
NEED NOT BE BUILT.



© Copyright 1995

MEADOW GROVE
BUILDING TYPE 2
BUILDING PLAN


J. BRADLEY MOORE
& ASSOCIATES ARCHITECTS
317 S. DIVISION STREET SUITE 1510 ANN ARBOR MI 48104-31784-1500

revisions

job 95310



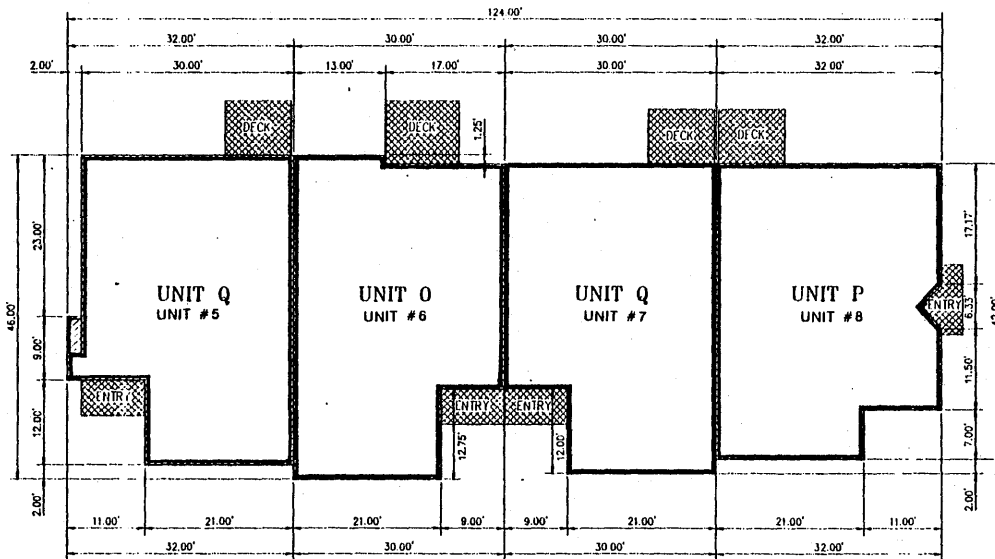

drawn JAN TRB
date 08/01/95
3/12/96

sht 13
JOB 95310



 
BUILDING TYPE 3

LEGEND

-  GENERAL COMMON ELEMENT
-  LIMITED COMMON ELEMENT
-  LIMITS OF OWNERSHIP
OWNERSHIP LINES ARE 90 DEGREES TO EACH OTHER UNLESS NOTED OTHERWISE
-  ENTRY PORCH

AREAS ARE COMPUTED FROM INTERIOR DIMENSIONS
 ALL WALLS ARE .42 FEET THICK UNLESS NOTED OTHERWISE
 ALL DIMENSIONS ARE IN FEET

SCALE: 1/8" = 1'-0"




J. BRADLEY MOORE
 LICENSED ARCHITECT NO. 31784

PROPOSED DATE 08/01/95

J. BRADLEY MOORE & ASSOCIATES
 ARCHITECTS INCORPORATED
 317 S. DIVISION STREET SUITE 1510
 ANN ARBOR, MICHIGAN 48104
 (313) 930-1500

UNITS 5-8 HAVE BEEN BUILT
 ALL OTHER UNITS
 NEED NOT BE BUILT.

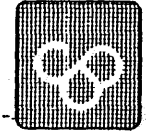

© Copyright 1995

MEADOW GROVE
 BUILDING TYPE 3
 BUILDING PLAN


J. BRADLEY MOORE
 & ASSOCIATES ARCHITECTS
 317 S. Division Suite 1510 Ann Arbor MI 48104 313/930-1500

revisions

job 95310

drawn JMH, TPO
 date 08/01/95
 1/16/96

ahh 14

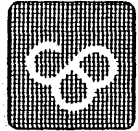

© Copyright 1995


MEADOW GROVE
CONDOMINIUMS
BUILDING TYPE 4 and 5
BUILDING PLANS

J BRADLEY MOORE
& ASSOCIATES ARCHITECTS
317 S Division Suite 1510 Ann Arbor MI 48104 313/930-1500

revisions



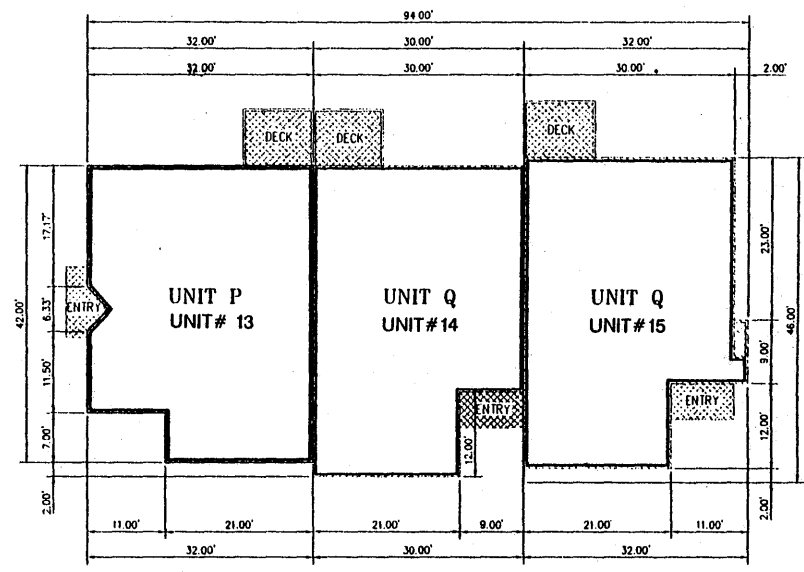

job 95310

drawn JAN
date 08/01/95
3/10/10
sht 15



BUILDING TYPE 4

LEGEND


-  GENERAL COMMON ELEMENT
-  LIMITED COMMON ELEMENT
-  UNITS OF OWNERSHIP
OWNERSHIP LINES ARE 90 DEGREES TO
EACH OTHER UNLESS NOTED OTHERWISE
-  ENTRY PORCH

AREAS ARE COMPUTED FROM INTERIOR DIMENSIONS

ALL WALLS ARE .42 FEET THICK UNLESS NOTED OTHERWISE

ALL DIMENSIONS ARE IN FEET

SCALE: 1/8" = 1'-0"

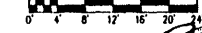


J. BRADLEY MOORE
LICENSED ARCHITECT NO. 31784


PROPOSED DATE 08/01/95

J. BRADLEY MOORE & ASSOCIATES
ARCHITECTS INCORPORATED
317 S. DIVISION STREET SUITE 1510
ANN ARBOR, MICHIGAN 48104
(313) 930-1500


UNITS 5-8 HAVE BEEN BUILT.
ALL OTHER UNITS
NEED NOT BE BUILT.

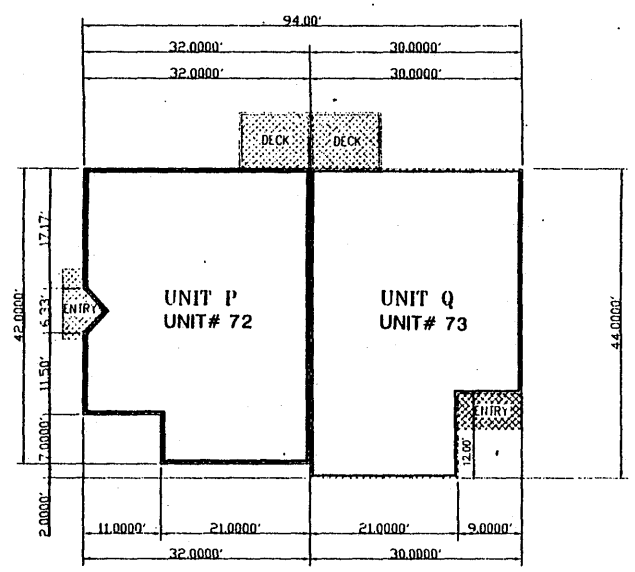


BUILDING TYPE 5

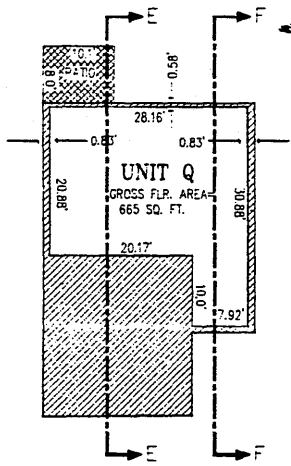


FOUNDATION PLAN

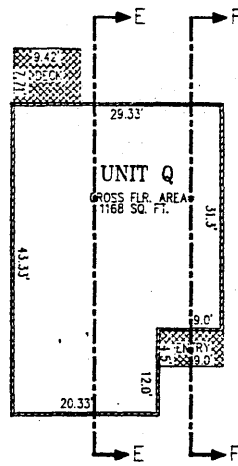


FIRST FLOOR PLAN

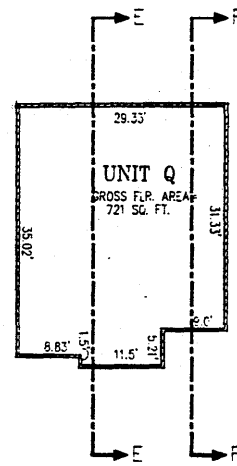


SECOND FLOOR PLAN

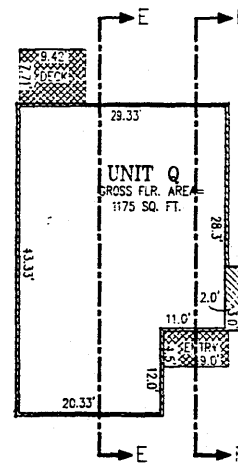


FIRST FLOOR PLAN
(END UNIT)

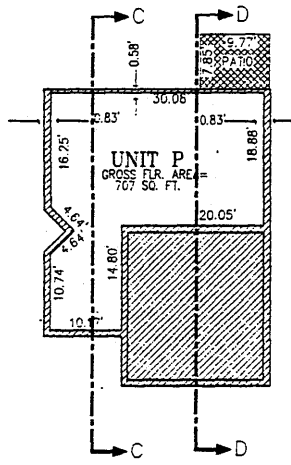

FOUNDATION PLAN

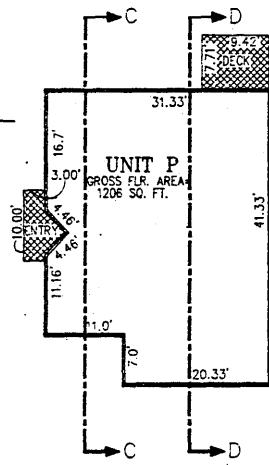

FIRST FLOOR PLAN

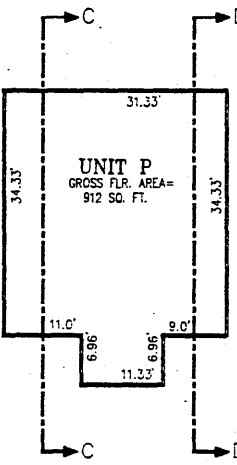

SECOND FLOOR PLAN

UNIT "P" PLAN			
UNIT NO.	BUILDING STYLE	BUILDING PAGE NO.	TYPE
28, 32, 36, 40	WALK-OUT	2	13
44, 58, 62	WALK-OUT	2	13
77	WALK-OUT	2	13

UNIT "Q" PLAN			
UNIT NO.	BUILDING STYLE	BUILDING PAGE NO.	TYPE
21, 33, 37, 41	WALK-OUT	2	13
45, 54, 62, 70	WALK-OUT	2	13
76	WALK-OUT	2	13

UNIT "O" PLAN			
UNIT NO.	BUILDING STYLE	BUILDING PAGE NO.	TYPE
34, 36, 38, 42	WALK-OUT	2	13
46, 50, 64, 68	WALK-OUT	2	13
72	WALK-OUT	2	13


UNIT "O" PLAN (END UNIT)			
UNIT NO.	BUILDING STYLE	BUILDING PAGE NO.	TYPE
31, 35, 39, 43	WALK-OUT	2	13
47, 52, 60, 66	WALK-OUT	2	13
74	WALK-OUT	2	13

LEGEND

- GENERAL COMMON ELEMENT
- LIMITED COMMON ELEMENT
- LIMITS OF OWNERSHIP
OWNERSHIP LINES ARE 90 DEGREES TO EACH OTHER UNLESS NOTED OTHERWISE
- ENTRY PORCH

AREAS ARE COMPUTED FROM INTERIOR DIMENSIONS
ALL WALLS ARE .42 FEET THICK UNLESS NOTED OTHERWISE
ALL DIMENSIONS ARE IN FEET

 SCALE: 1/8" = 1'-0"




J. BRADLEY MOORE
LICENSED ARCHITECT NO. 31784


PROPOSED DATE 08/01/95

J. BRADLEY MOORE & ASSOCIATES
ARCHITECTS INCORPORATED
317 S. DIVISION STREET SUITE 1510
ANN ARBOR, MICHIGAN 48104
(313) 930-1500


UNITS 5-8 HAVE BEEN BUILT
ALL OTHER UNITS
NEED NOT BE BUILT.

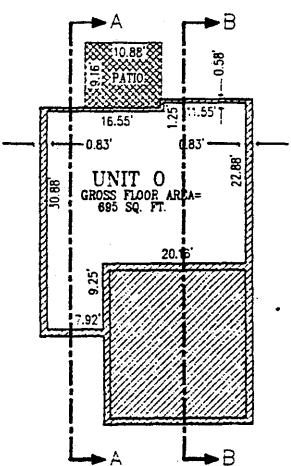

FOUNDATION PLAN

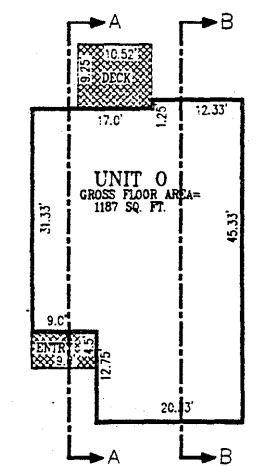

FIRST FLOOR PLAN

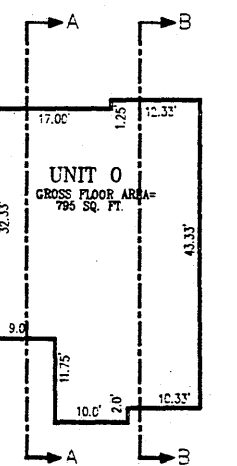

SECOND FLOOR PLAN

DATE 08/01/95
JOB NO. 95310
SHEET NO. 16


JOB NO. 95310


PROVISIONS

J. BRADLEY MOORE & ASSOCIATES ARCHITECTS
317 S. DIVISION STREET SUITE 1510 ANN ARBOR MI 48104 313/930-1500


MEADOW GROVE
UNITS O.P.Q
WALK-OUTS
FLOOR PLANS

© Copyright 1995

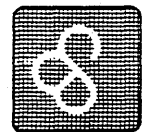


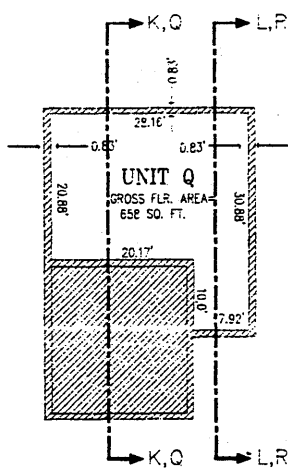


FOUNDATION PLAN

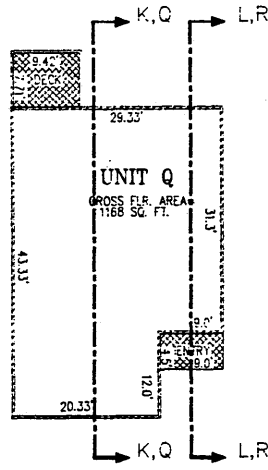


FIRST FLOOR PLAN

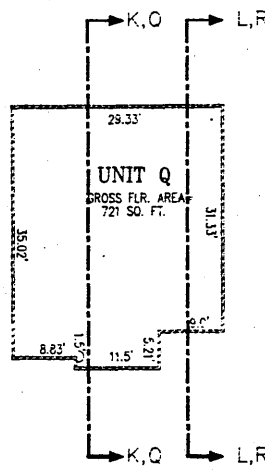


SECOND FLOOR PLAN

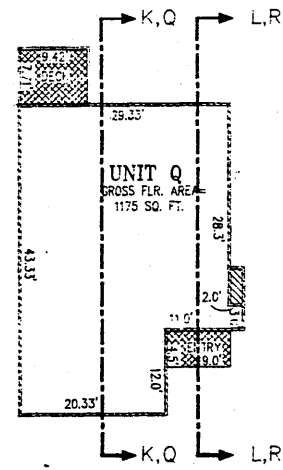


FIRST FLOOR PLAN
(END UNIT)

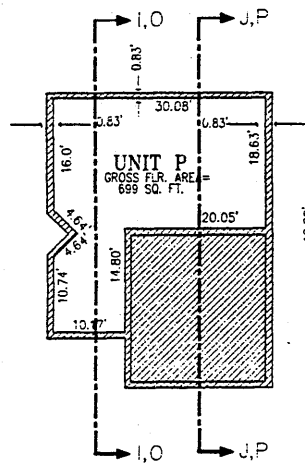

FOUNDATION PLAN

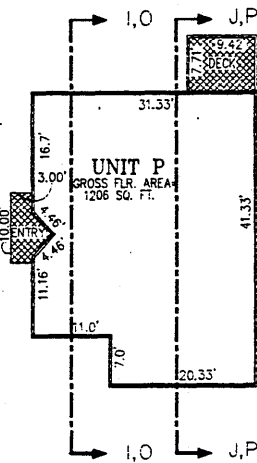

FIRST FLOOR PLAN

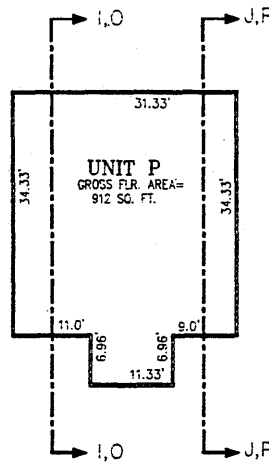

SECOND FLOOR PLAN

UNIT "P" PLAN

UNIT NO.	BUILDING STYLE	BUILDING PAGE NO.	TYPE
9, 24, 28, 29	VIEW-OUT	2	13
24, 76	VIEW-OUT	2	13
5	BASEMENT	3	14
72, 5	VIEW-OUT	5, 4	14

UNIT "Q" PLAN


UNIT NO.	BUILDING STYLE	BUILDING PAGE NO.	TYPE
10, 21, 25, 57	VIEW-OUT	2	13
65, 79	VIEW-OUT	2	13
7	BASEMENT	3	14
14	VIEW-OUT	4	14

UNIT "O" PLAN


UNIT NO.	BUILDING STYLE	BUILDING PAGE NO.	TYPE
11, 22, 26, 56	VIEW-OUT	2	13
66, 80	VIEW-OUT	2	13
6	BASEMENT	3	14
14	VIEW-OUT	4	14

UNIT "C" PLAN (END UNIT)


UNIT NO.	BUILDING STYLE	BUILDING PAGE NO.	TYPE
12, 23, 27, 59	VIEW-OUT	2	13
67, 81	VIEW-OUT	2	13
7	BASEMENT	3	14
72, 5	VIEW-OUT	5, 4	14

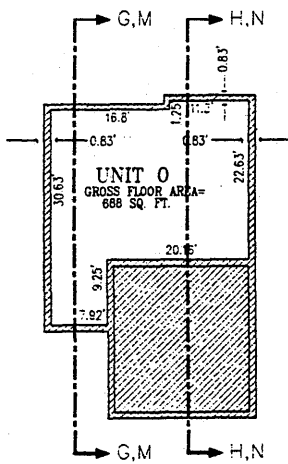

FOUNDATION PLAN

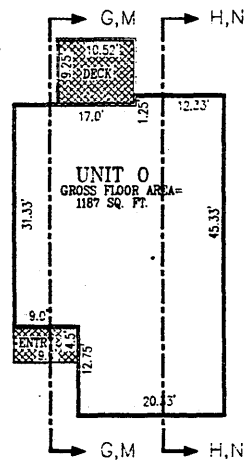

FIRST FLOOR PLAN

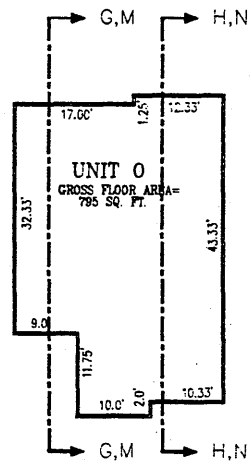


SECOND FLOOR PLAN

LEGEND

- GENERAL COMMON ELEMENT
 - LIMITED COMMON ELEMENT
 - LIMITS OF OWNERSHIP
OWNERSHIP LINES ARE 90 DEGREES TO EACH OTHER UNLESS NOTED OTHERWISE
 - ENTRY PORCH
- AREAS ARE COMPUTED FROM INTERIOR DIMENSIONS
ALL WALLS ARE .42 FEET THICK UNLESS NOTED OTHERWISE
ALL DIMENSIONS ARE IN FEET

 SCALE: 1/8" = 1'-0"



J. BRADLEY MOORE
LICENSED ARCHITECT NO. 31784
PROPOSED DATE 08/01/95



J. BRADLEY MOORE & ASSOCIATES
ARCHITECTS INCORPORATED
317 S. DIVISION STREET SUITE 1510
ANN ARBOR, MICHIGAN 48104
(313) 930-1500

UNITS 5-8 HAVE BEEN BUILT
ALL OTHER UNITS
NEED NOT BE BUILT.

shl
17
drawn
date 08/01/95
3/16/96

job 95310


revisions

J BRADLEY MOORE
& ASSOCIATES ARCHITECTS
317 S Division Street 1510 Ann Arbor MI 48104 313/930-1500


MEADOW GROVE
UNITS O,P,Q
BASEMENTS & VIEW-OUTS
FLOOR PLANS

© Copyright 1995



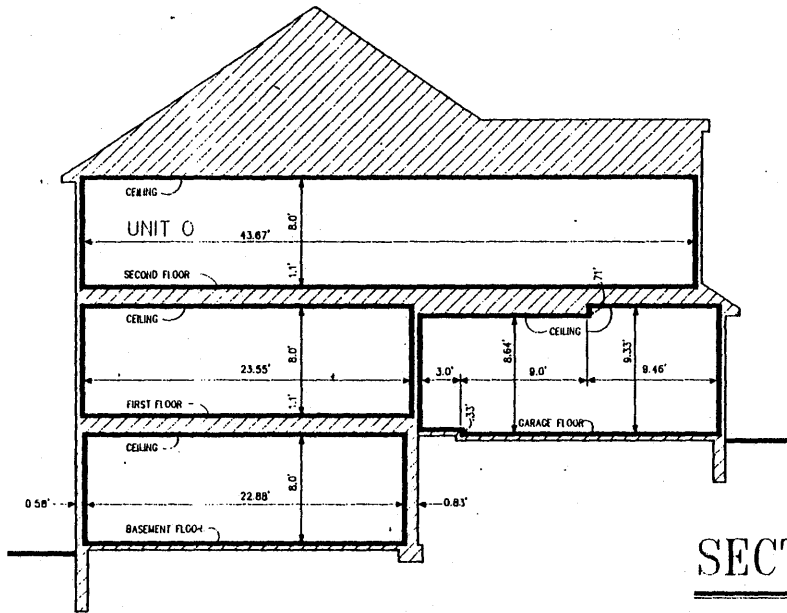



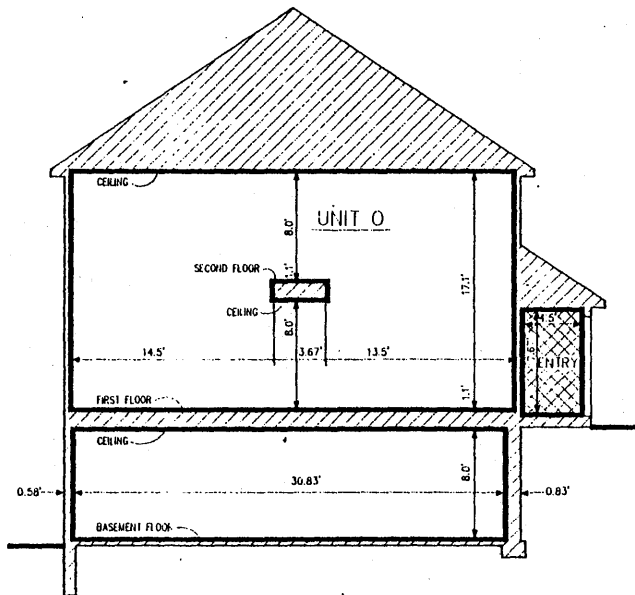

SECTION B



SECTION A

LEGEND

-  GENERAL COMMON ELEMENT
-  LIMITED COMMON ELEMENT
-  LIMITS OF OWNERSHIP
OWNERSHIP LINES ARE 90 DEGREES TO
EACH OTHER UNLESS NOTED OTHERWISE
-  ENTRY PORCH

• AREAS ARE COMPUTED FROM INTERIOR DIMENSIONS

ALL WALLS ARE .42 FEET THICK UNLESS NOTED OTHERWISE

ALL DIMENSIONS ARE IN FEET

SCALE: 1/4" = 1'-0"



J. BRADLEY MOORE
LICENSED ARCHITECT NO. 31784

PROPOSED DATE 08/01/95

J. BRADLEY MOORE & ASSOCIATES
ARCHITECTS INCORPORATED
317 S. DIVISION STREET SUITE 1510
ANN ARBOR, MICHIGAN 48104
(313) 930-1500

UNITS 5-8 HAVE BEEN BUILT
ALL OTHER UNITS
NEED NOT BE BUILT.



© Copyright 1995

MEADOW GROVE
UNIT 0 - WALK-OUTS
SECTIONS


J. BRADLEY MOORE
& ASSOCIATES ARCHITECTS
317 S. Division Street 1510 Ann Arbor MI 48104 313/930-1500

revisions


job 94140

drawn mwb
date 09/01/95
5/7/96

sht 18

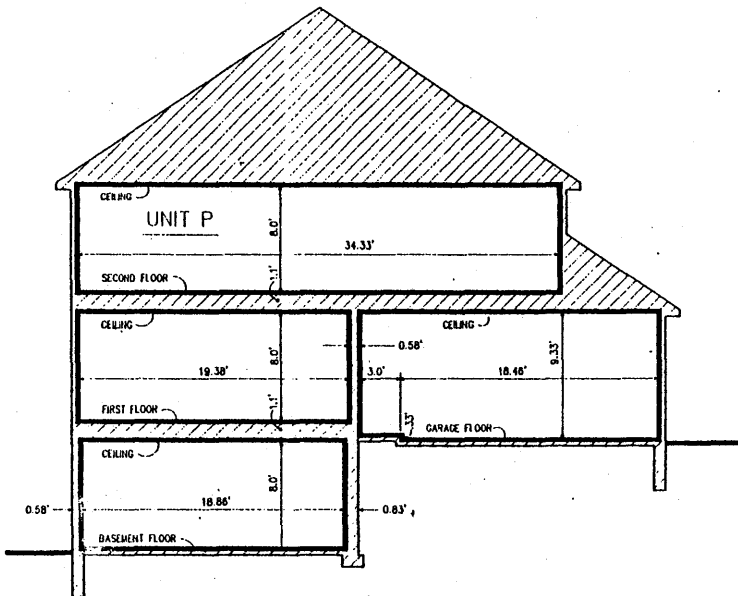



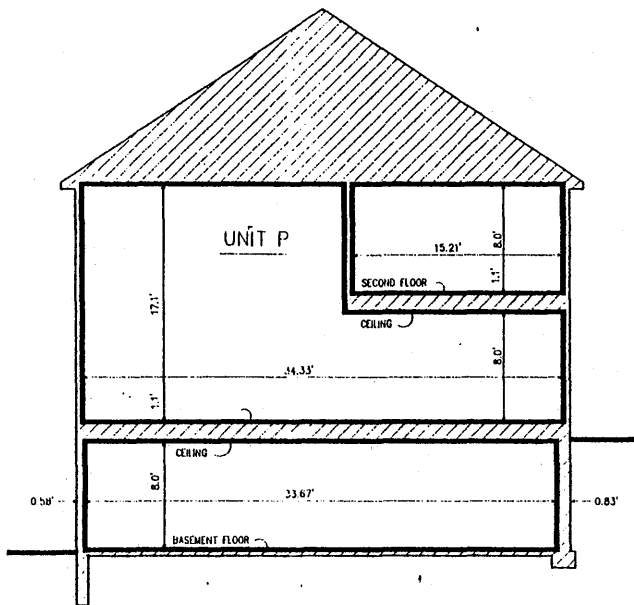

SECTION D



SECTION C

LEGEND

-  GENERAL COMMON ELEMENT
-  LIMITED COMMON ELEMENT
-  LIMITS OF OWNERSHIP
OWNERSHIP LINES ARE 90 DEGREES TO
EACH OTHER UNLESS NOTED OTHERWISE
-  ENTRY PORCH

AREAS ARE COMPUTED FROM INTERIOR DIMENSIONS

ALL WALLS ARE .42 FEET THICK UNLESS NOTED OTHERWISE

ALL DIMENSIONS ARE IN FEET

SCALE: 1/4" = 1'-0"



J. BRADLEY MOORE
LICENSED ARCHITECT NO. 31784

PROPOSED DATE 08/01/95

J. BRADLEY MOORE & ASSOCIATES
ARCHITECTS INCORPORATED
317 S. DIVISION STREET SUITE 1510
ANN ARBOR, MICHIGAN 48104
(313) 930-1500

UNITS 5-8 HAVE BEEN BUILT
ALL OTHER UNITS
NEED NOT BE BUILT.



© Copyright 1995

MEADOW GROVE
UNIT P - WALK-OUTS
SECTIONS

J. BRADLEY MOORE
& ASSOCIATES ARCHITECTS
317 S. Division Street, Suite 1510 Ann Arbor MI 48104 313/930-1500

revisions

job 94140

drawn umg
date 08/01/95
1/16/96

sht 19



© Copyright 1995

MEADOW GROVE
UNIT Q - WALK-OUTS
SECTIONS


J BRADLEY MOORE
& ASSOCIATES ARCHITECTS
317 S Division Suite 1510 Ann Arbor MI 48104 313/766-1500

revisions


job 94140

drawn wmb
date 08/01/95
3/16/10

shl 20

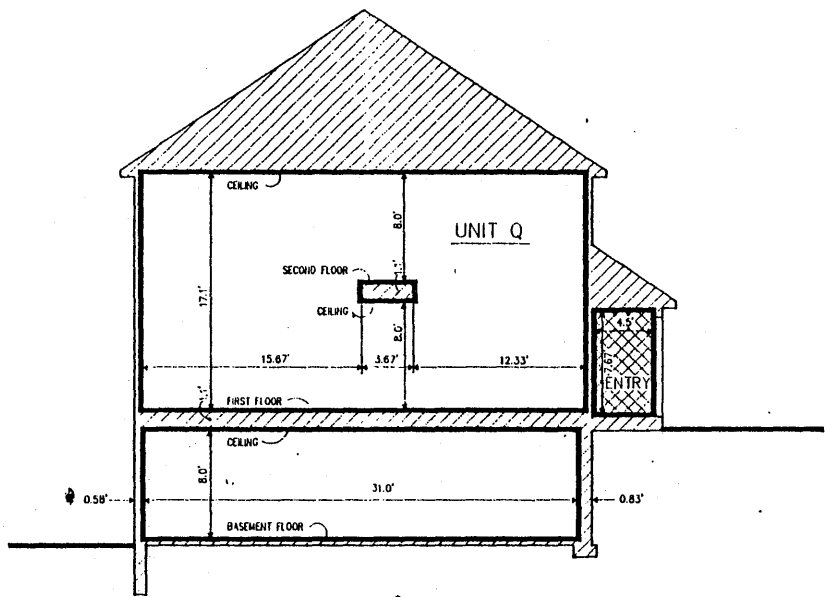



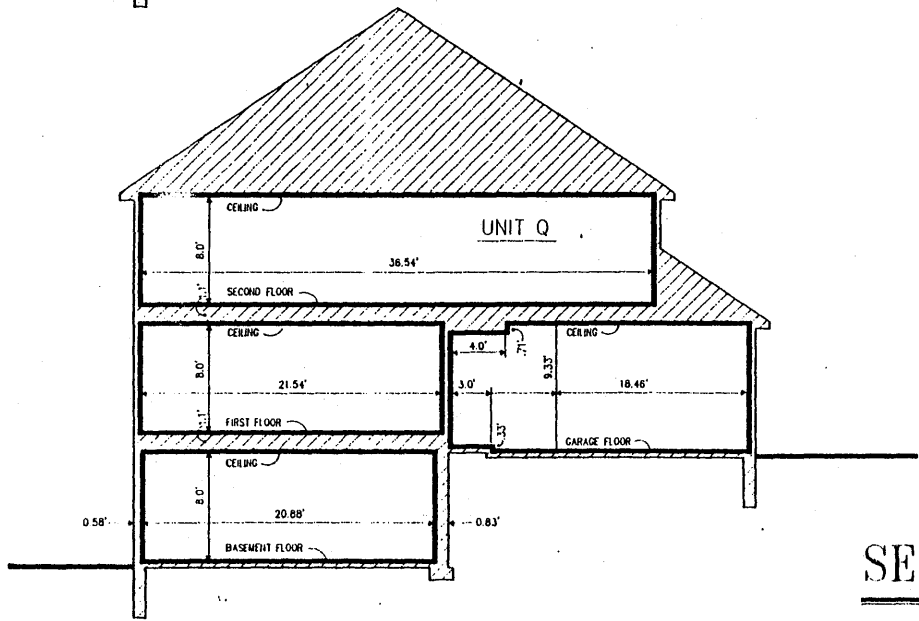

SECTION F




SECTION E

LEGEND

-  GENERAL COMMON ELEMENT
-  LIMITED COMMON ELEMENT
-  LIMITS OF OWNERSHIP
OWNERSHIP LINES ARE 90 DEGREES TO EACH OTHER UNLESS NOTED OTHERWISE
-  ENTRY PORCH

AREAS ARE COMPUTED FROM INTERIOR DIMENSIONS
 ALL WALLS ARE .42 FEET THICK UNLESS NOTED OTHERWISE
 ALL DIMENSIONS ARE IN FEET

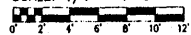
SCALE: 1/4" = 1'-0"


J. BRADLEY MOORE
 LICENSED ARCHITECT NO. 31784
 PROPOSED DATE 08/01/95




J. BRADLEY MOORE & ASSOCIATES
 ARCHITECTS INCORPORATED
 317 S. DIVISION STREET SUITE 1510
 ANN ARBOR, MICHIGAN 48104
 (313) 930-1500

UNITS 5-8 HAVE BEEN BUILT
 ALL OTHER UNITS
 NEED NOT BE BUILT.

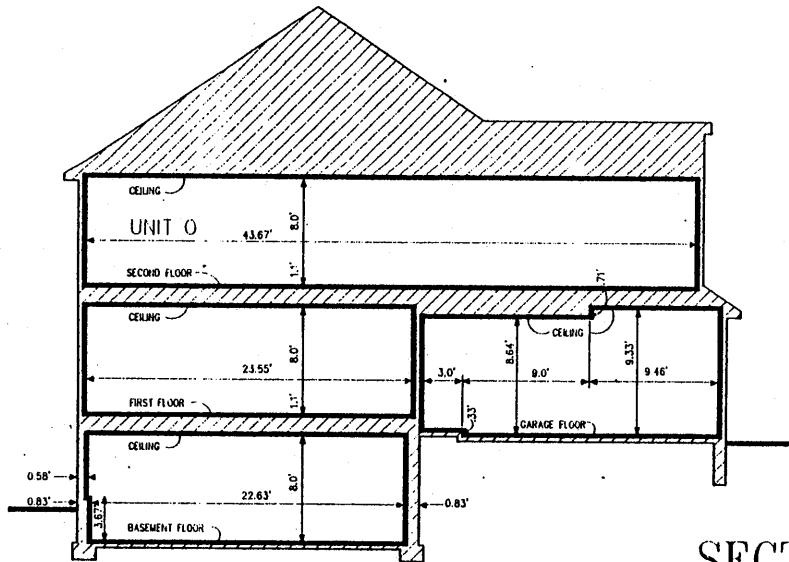



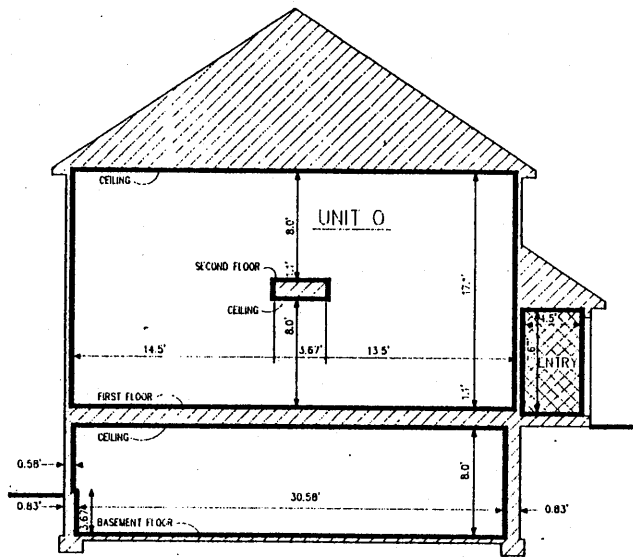

SECTION H



SECTION G

LEGEND


-  GENERAL COMMON ELEMENT
-  LIMITED COMMON ELEMENT
-  LIMITS OF OWNERSHIP
OWNERSHIP LINES ARE 90 DEGREES TO EACH OTHER UNLESS NOTED OTHERWISE
-  ENTRY PORCH

AREAS ARE COMPUTED FROM INTERIOR DIMENSIONS

ALL WALLS ARE .42 FEET THICK UNLESS NOTED OTHERWISE

ALL DIMENSIONS ARE IN FEET

SCALE: 1/4" = 1'-0"

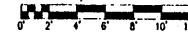


J. BRADLEY MOORE
LICENSED ARCHITECT NO. 31784

PROPOSED DATE 08/01/95

J. BRADLEY MOORE & ASSOCIATES
ARCHITECTS INCORPORATED
317 S. DIVISION STREET SUITE 1510
ANN ARBOR, MICHIGAN 48104
(313) 930-1500



UNITS 5-8 HAVE BEEN BUILT
ALL OTHER UNITS
NEED NOT BE BUILT.

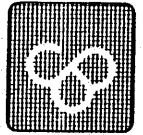

© Copyright 1995

MEADOW GROVE
UNIT 0 - VIEW OUT
SECTIONS

J. BRADLEY MOORE
& ASSOCIATES ARCHITECTS
317 S. Division Street 1510 Ann Arbor MI 48106 313/930-1500

revisions

job 95310

drawn mmb
date 08/01/95
9/16/95

sh 21



© Copyright 1995

MEADOW GROVE
UNIT P - VIEW OUT
SECTIONS


J BRADLEY MOORE
& ASSOCIATES ARCHITECTS
317 S. DIVISION SUITE 1510 ANN ARBOR MI 48104 313/765-1500

revisions


job 95310

drawn WMB
date 11/01/95
2/16/96

sh1 22

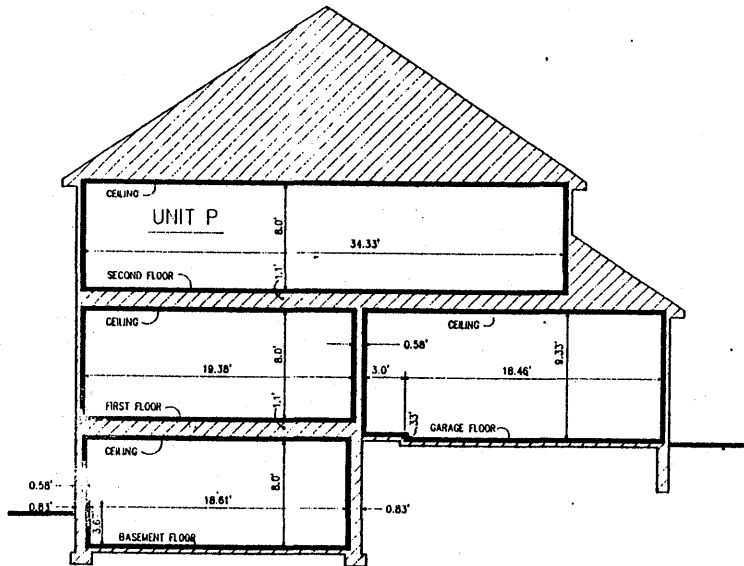



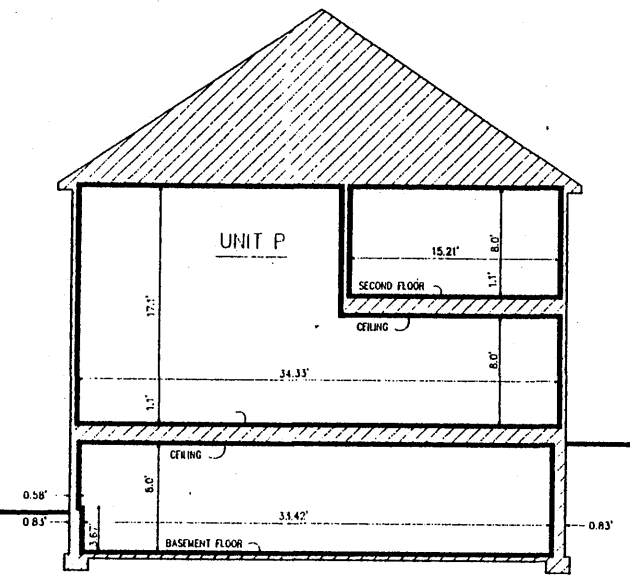

SECTION J



SECTION I

LEGEND


-  GENERAL COMMON ELEMENT
-  LIMITED COMMON ELEMENT
-  LIMITS OF OWNERSHIP
OWNERSHIP LINES ARE 90 DEGREES TO EACH OTHER UNLESS NOTED OTHERWISE
-  ENTRY PORCH

AREAS ARE COMPUTED FROM INTERIOR DIMENSIONS

ALL WALLS ARE .42 FEET THICK UNLESS NOTED OTHERWISE

ALL DIMENSIONS ARE IN FEET

SCALE: 1/4" = 1'-0"

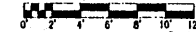

J. BRADLEY MOORE
LICENSED ARCHITECT NO. 31784

PROPOSED DATE 08/01/95

J. BRADLEY MOORE & ASSOCIATES
ARCHITECTS INCORPORATED
317 S. DIVISION STREET SUITE 1510
ANN ARBOR, MICHIGAN 48104
(313) 930-1500

UNITS 5-8 HAVE BEEN BUILT
ALL OTHER UNITS
NEED NOT BE BUILT.





© Copyright 1995


MEADOW GROVE
UNIT Q - VIEW OUT
SECTIONS

J BRADLEY MOORE
& ASSOCIATES ARCHITECTS
317 S. Division Street, 1510 Ann Arbor, MI 48104-3170-1500


revisions

job 95310

drawn mws
date 08/01/95
5/16/98
sht 23

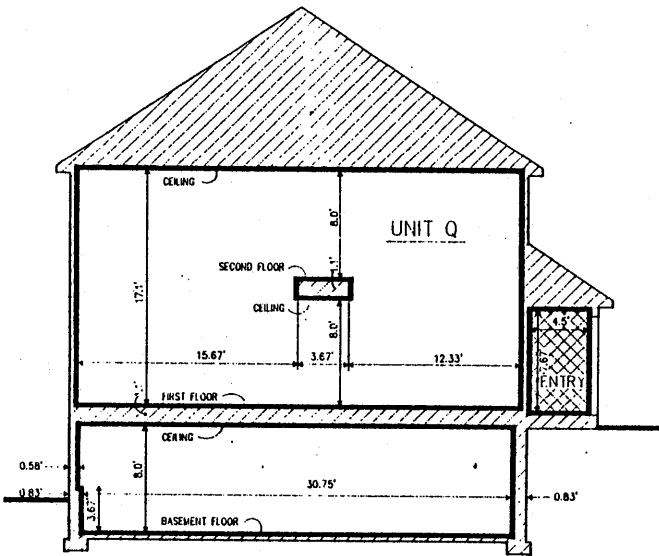

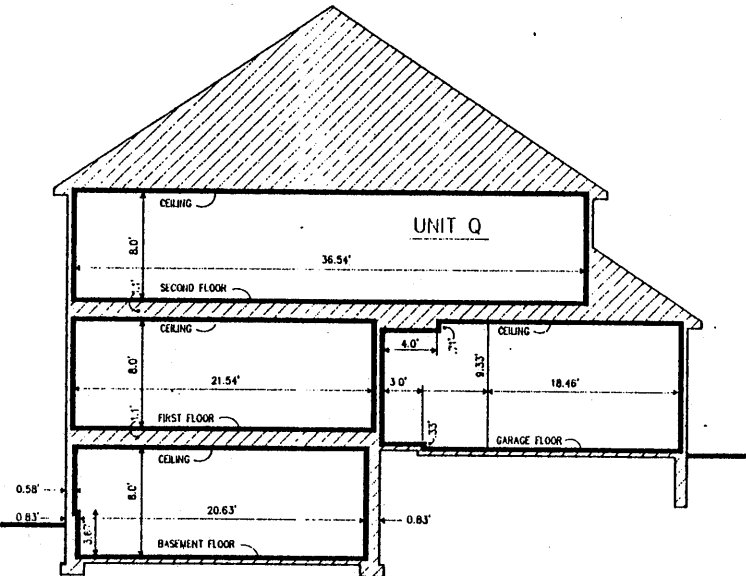



SECTION L



SECTION K

LEGEND

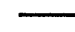
-  GENERAL COMMON ELEMENT
-  LIMITED COMMON ELEMENT
-  LIMITS OF OWNERSHIP
OWNERSHIP LINES ARE 90 DEGREES TO
EACH OTHER UNLESS NOTED OTHERWISE
-  ENTRY PORCH

AREAS ARE COMPUTED FROM INTERIOR DIMENSIONS

ALL WALLS ARE .42 FEET THICK UNLESS NOTED OTHERWISE

ALL DIMENSIONS ARE IN FEET

SCALE: 1/4" = 1'-0"

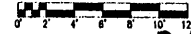


J. BRADLEY MOORE
LICENSED ARCHITECT NO. 31784

PROPOSED DATE 08/01/95


J. BRADLEY MOORE & ASSOCIATES
ARCHITECTS INCORPORATED
317 S. DIVISION STREET SUITE 1510
ANN ARBOR, MICHIGAN 48104
(313) 930-1500

UNITS 5-8 HAVE BEEN BUILT
ALL OTHER UNITS
NEED NOT BE BUILT.



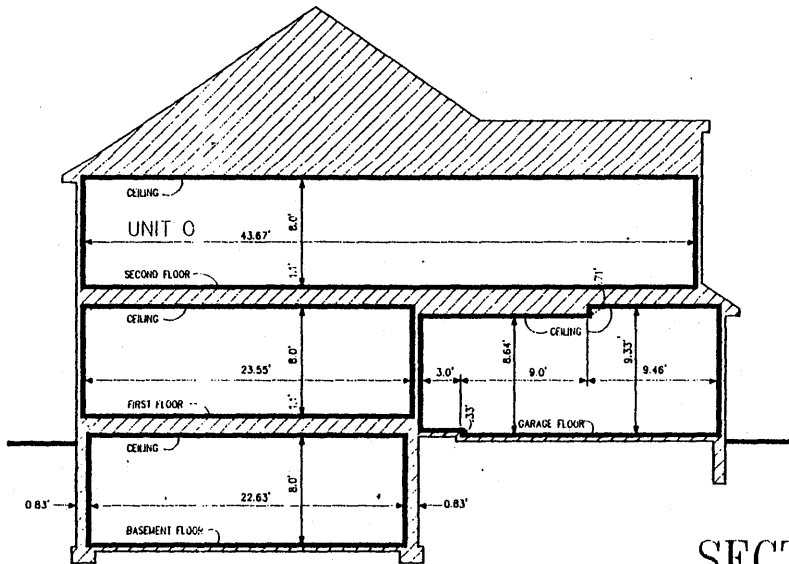


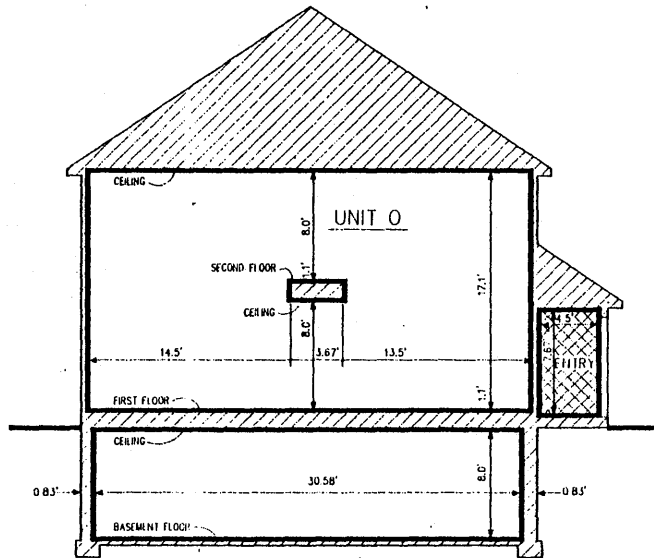


SECTION N



 SECTION M

LEGEND

 
-  GENERAL COMMON ELEMENT
-  LIMITED COMMON ELEMENT
-  LIMITS OF OWNERSHIP
OWNERSHIP LINES ARE 90 DEGREES TO EACH OTHER UNLESS NOTED OTHERWISE
-  ENTRY PORCH

AREAS ARE COMPUTED FROM INTERIOR DIMENSIONS

ALL WALLS ARE .42 FEET THICK UNLESS NOTED OTHERWISE

ALL DIMENSIONS ARE IN FEET

SCALE: 1/4" = 1'-0"



J. BRADLEY MOORE
LICENSED ARCHITECT NO. 31784

PROPOSED DATE: 08/01/95

J. BRADLEY MOORE & ASSOCIATES
ARCHITECTS INCORPORATED
317 S. DIVISION STREET SUITE 1510
ANN ARBOR, MICHIGAN 48104
(313) 930-1500

UNITS 5-8 HAVE BEEN BUILT
ALL OTHER UNITS
NEED NOT BE BUILT.



© Copyright 1995

MEADOW GROVE
UNIT 0-BASEMENT
SECTIONS


J. BRADLEY MOORE
& ASSOCIATES ARCHITECTS
317 S. Division Street 1510 Ann Arbor MI 48104 313/930-1500

revisions


job 95310

drawn mwo
date 08/01/95
3/16/98

shh 24

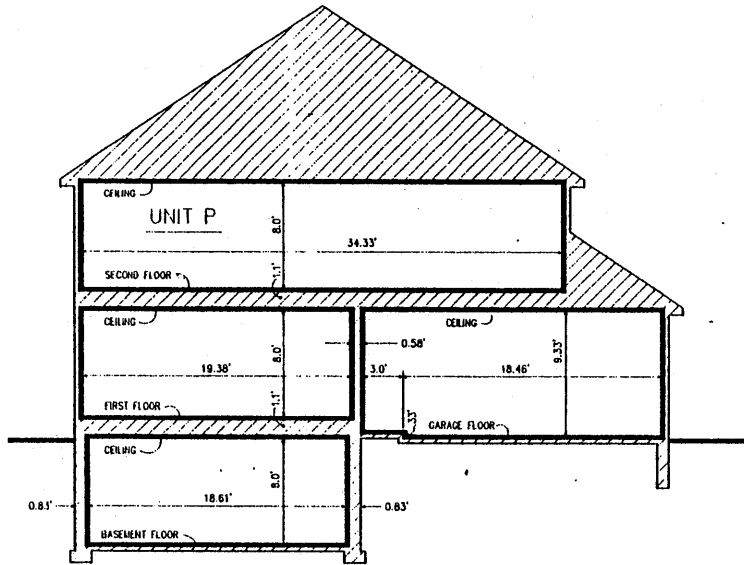


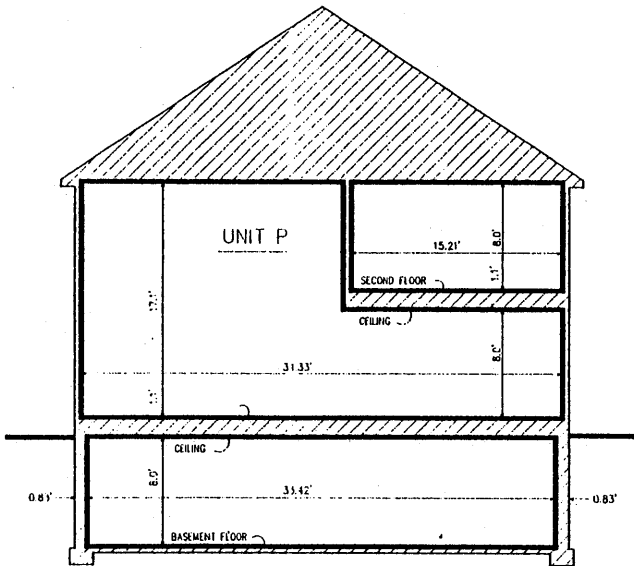


SECTION P



 SECTION O

LEGEND

 
-  GENERAL COMMON ELEMENT
-  LIMITED COMMON ELEMENT
-  LIMITS OF OWNERSHIP
OWNERSHIP LINES ARE 90 DEGREES TO EACH OTHER UNLESS NOTED OTHERWISE
-  ENTRY PORCH

AREAS ARE COMPUTED FROM INTERIOR DIMENSIONS

ALL WALLS ARE .42 FEET THICK UNLESS NOTED OTHERWISE

ALL DIMENSIONS ARE IN FEET

SCALE: 1/4" = 1'-0"



J. BRADLEY MOORE
LICENSED ARCHITECT NO. 31784

PROPOSED DATE: 08/01/95

J. BRADLEY MOORE & ASSOCIATES
ARCHITECTS INCORPORATED
317 S. DIVISION STREET SUITE 1510
ANN ARBOR, MICHIGAN 48104
(313) 930-1500

UNITS 5-8 HAVE BEEN BUILT
ALL OTHER UNITS
NEED NOT BE BUILT.



© Copyright 1995

MEADOW GROVE
UNIT P - BASEMENT
SECTIONS


J. BRADLEY MOORE
& ASSOCIATES ARCHITECTS
317 S. Division Street, Suite 1510 Ann Arbor, MI 48104 313/930-1500

revisions


job 95310

drawn mwb
date 08/01/95
3/16/98

shl 25

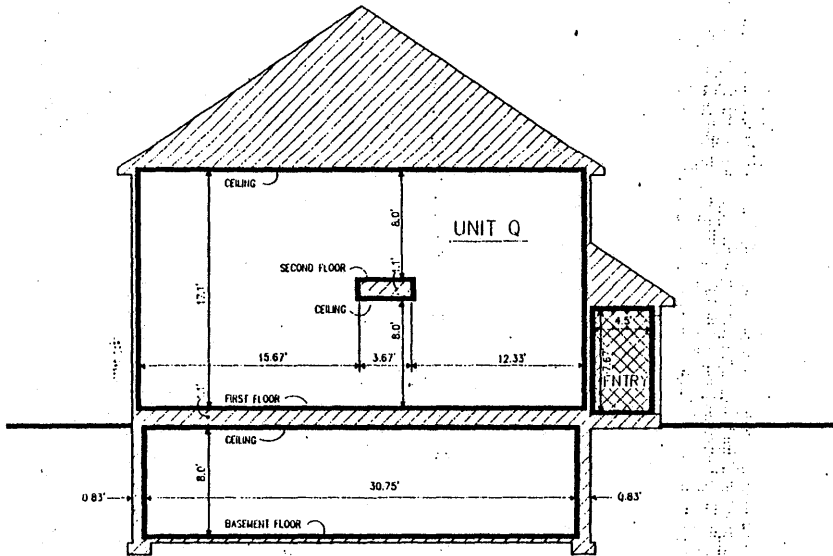



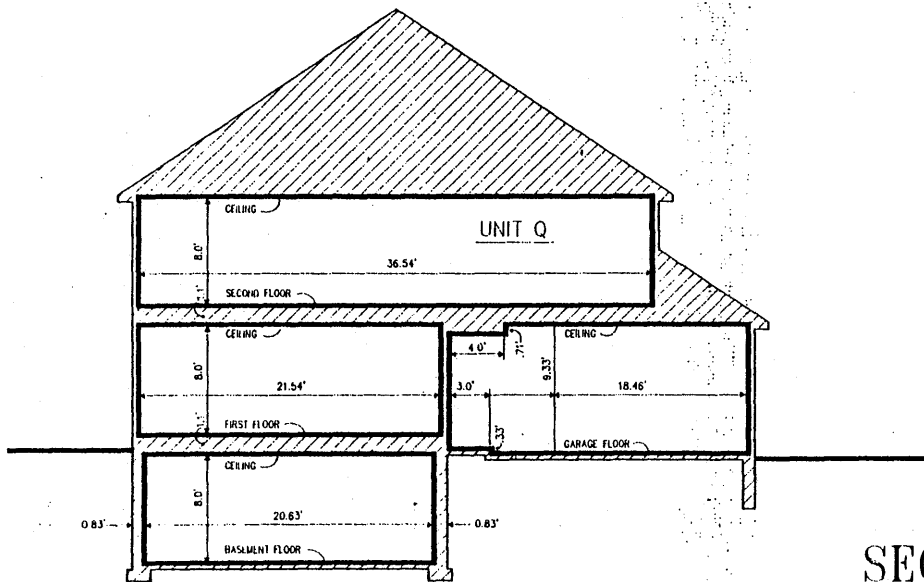

SECTION R



SECTION Q

LEGEND

-  GENERAL COMMON ELEMENT
-  LIMITED COMMON ELEMENT
-  LIMITS OF OWNERSHIP
OWNERSHIP LINES ARE 90 DEGREES TO
EACH OTHER UNLESS NOTED OTHERWISE
-  ENTRY PORCH

AREAS ARE COMPUTED FROM INTERIOR DIMENSIONS

ALL WALLS ARE .42 FEET THICK UNLESS NOTED OTHERWISE

ALL DIMENSIONS ARE IN FEET

SCALE: 1/4" = 1'-0"



J. BRADLEY MOORE
LICENSED ARCHITECT NO. 31784

PROPOSED DATE 08/01/95

J. BRADLEY MOORE & ASSOCIATES
ARCHITECTS INCORPORATED
317 S. DIVISION STREET SUITE 1510
ANN ARBOR, MICHIGAN 48104
(313) 930-1500

UNITS 5-B HAVE BEEN BUILT
ALL OTHER UNITS
NEED NOT BE BUILT.



© Copyright 1995

MEADOW GROVE
UNIT Q-BASEMENT
SECTIONS

J. BRADLEY MOORE
& ASSOCIATES ARCHITECTS
317 S. Division Street 1510 Ann Arbor, MI 48104 313/930-1500

revisions

job 95310

drawn mwg
date 08/01/95
5/16/96

sht 26